

HARRISON
M 54
10-21-72

CODED

MISSISSIPPI
BOARD OF WATER COMMISSIONERS
416 North State Street
Jackson, Mississippi 39201

WATER WELL DRILLERS LOG

Oct 21-72 19 R. J. Mooka HARRISON
date well completed firm name county well located

LANDOWNER: S. E. Wright
RTS Box 187
Blount ms
(mailing address)

description of formations encountered	from	to
TOP SOIL	0	10
Orange clay	10	50
Rusty sand	50	60
Blue clay	60	195
Gravel sand	195	207

WELL LOCATION:
sec 14 T 2 N R 10 E
2 miles S of COOPER LAKE
(distance) (direction) (nearest town)

WELL PURPOSE:
(home, irrigation, municipal, industrial)


- WELL COMPLETION DATA:
- (1) diameter (inches) 2"
 - (2) total depth (feet) 207
 - (3) static water level (feet) 22' below above top of ground.
 - (4) casing galv 197'
(material) (depth)
(size) if telescope see back.
 - (5) screen 10' 197'
(length) (depth to top)
2" SS
(size) (material)
 - (6) pump 0 -
(HP) (yield gpm)
(type power)
 - (7) electric log (yes or no)
(organization running log)
 - (8) how well bottom plugged Bad
white

CODED

DRILLERS REMARKS:

If well telescopes please sketch and show depths.

GROUND LEVEL

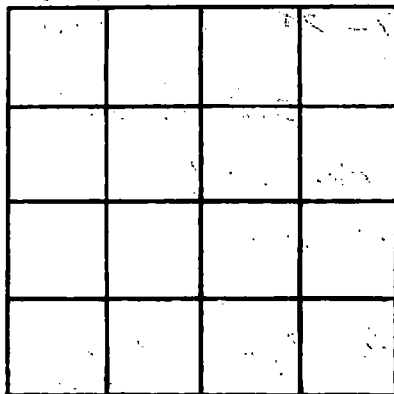

SECTION _____

Please indicate well location X.

ADDITIONAL INFORMATION

If more than one screen, show locations of each on sketch.