

HARRISON Co

M550

Elog #97

MISSISSIPPI  
BOARD OF WATER COMMISSIONERS  
416 North State Street  
Jackson, Mississippi 39201

## WATER WELL DRILLERS LOG

11-20-72  
date well completedHager-Layne Central Dist.  
firm nameHarrison  
county well located

## LANDOWNER:

City of Biloxi

Biloxi, Miss.  
(mailing address)

## WELL LOCATION:

Porter Street  
sec. 29 T 7 S R 9 W

(distance) miles (direction) of (nearest town)

## WELL PURPOSE:

Municipal  
(home, irrigation, municipal, industrial)

## WELL COMPLETION DATA:

- (1) diameter (inches) 16"  
(2) total depth (feet) 640'  
(3) static water level (feet) 45 below top of ground.

- (4) casing Steel 560'  
(material) (depth)

16" if telescope see back.  
(size) 66' 8 3"

- (5) screen 70' 564'  
(length) (depth to top)

8" Stainless Steel  
(size) (material)

- (6) pump 75 700  
(HP) (yield gpm)

Electric  
(type power)

- (7) electric log yes  
(yes or no)

Schlumberger  
(organization running log)

- (8) how well bottom plugged None

## description of formations encountered

from to

Sand	0	42
Clay & Sand & Shale	42	98
Sand & Clay	98	153
Clay & Sand & Shale	153	255
Sand	255	270
Tough clay	270	330
Fine Sand & Clay & Shale	330	365
Sandy Clay	365	430
Sand	430	480
Hard Clay & Sandy Shale	480	560
Sand & Gravel & Sand	560	665
Clay & Sand	665	748
Sand & Shale streaks	748	805
Shale & Sand streaks	805	840
Sandy Shale	840	925
Coarse Sand & Pea Gravel	925	1010
Sandy Shale	1010	1120
Sand & Shale streaks	1120	1185
Sandy Shale	1185	1250
Shale	1250	1265
Sandy Shale	1265	1325
Sand	1325	1355
Sandy Shale	1355	1401


560  
TOP  
100'

564  
70  
634

DRILLERS REMARKS:

If well telescopes please  
sketch and show depths.

GROUND LEVEL

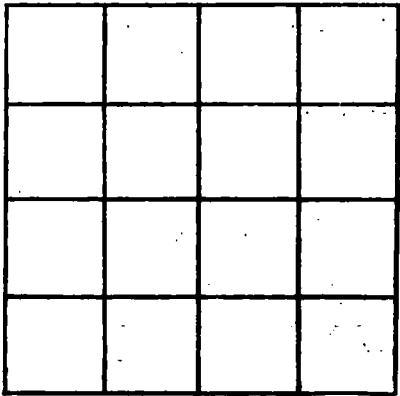

SECTION \_\_\_\_\_

Please indicate well location X.

ADDITIONAL INFORMATION

If more than one screen,  
show locations of each on sketch.