

HARRISON
M 557
11-13-72

MISSISSIPPI
BOARD OF WATER COMMISSIONERS
 416 North State Street
 Jackson, Mississippi 39201

WATER WELL DRILLERS LOG

COASTAL DRILLING & SERVICE CO.

county well located

11/13/72
 date well completed

ROUTE 1 BOX 618

LANDOWNER: Elmer Johnson

39537
 description of formations encountered

from to

Boodie, Miss
 (mailing address)

<u>Red Clay</u>	<u>6</u>	<u>9</u>
<u>Black Clay</u>	<u>9</u>	<u>15</u>
<u>White Sand</u>	<u>15</u>	<u>37</u>
<u>Soft Blue Clay</u>	<u>37</u>	<u>220</u>
<u>fine white sand</u>	<u>220</u>	<u>235</u>
<u>Dark Blue Clay</u>	<u>235</u>	<u>344</u>
<u>fine water sand</u>	<u>344</u>	<u>375</u>
<u>Coarse water sand</u>	<u>375</u>	<u>406</u>

WELL LOCATION:

sec 17 T 2 S R 9 E
2 miles N of Boodie
 (distance) (direction) (nearest town)

WELL PURPOSE: home
 (home, irrigation, municipal, industrial)

WELL COMPLETION DATA:

- (1) diameter (inches) 2"
- (2) total depth (feet) 406'
- (3) static water level (feet) 43 below above top of ground.
- (4) casing Flu. 396'
 (material) (depth)
- (5) screen 10' 396'
 (length) (depth to top)
2" S.S.
 (size) (material)
- (6) pump 1/2 HP 15
 (HP) (yield gpm)
- (7) electric log no
 (yes or no)

(organization running log)

(8) how well bottom plugged


2 feet back blue

DRILLERS REMARKS:

none

If well telescopes please sketch and show depths.

GROUND LEVEL

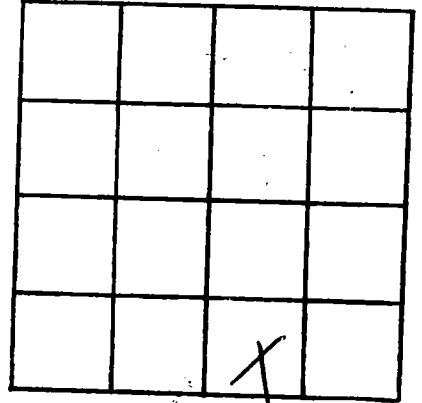

SECTION _____

Please indicate well location X.

ADDITIONAL INFORMATION

If more than one screen, show locations of each on sketch.