

HARRISON
M 558
8-25-72

MISSISSIPPI
BOARD OF WATER COMMISSIONERS
416 North State Street
Jackson, Mississippi 39201

WATER WELL DRILLERS LOG
COASTAL DRILLING & SERVICE CO.

8/25/72
date well completed

ROUTE 1 BOX 618
Biloxi, Miss. 39532

Harrison
county well located

LANDOWNER: Buften Stanley

description of formations encountered

from to

RT 5 Box 81
Biloxi, Miss
(mailing address)

description of formations encountered	from	to
Top Soil	1	2
Red Clay	2	3
Red + white Clay	5	36
White Clay	36	50
Soft Blue Clay	50	210
Light Blue Clay	210	465
fine water sand	465	485
Coarse water sand	485	495
light blue clay	495	595
fine water sand	595	675
Coarse water sand	675	660

WELL LOCATION:

sec 7 T 7 N R 9 E
S W
2 miles N Biloxi
(distance) (direction) (nearest town)

WELL PURPOSE: None
(home, irrigation, municipal, industrial)

WELL COMPLETION DATA:

- (1) diameter (inches) 2"
- (2) total depth (feet) 660'
- (3) static water level (feet) 48' below top of ground.
- (4) casing gal (material) 675' (depth)
- (5) screen 15' (length) 675' (depth to top)
2" (size) S.S. (material)
- (6) pump One (HP) 17 (yield gpm)
Ele (type power)
- (7) electric log no (yes or no)

(organization running log)


(8) how well bottom plugged 2" natural water

DRILLERS REMARKS:

None

If well telescopes please sketch and show depths.

GROUND LEVEL

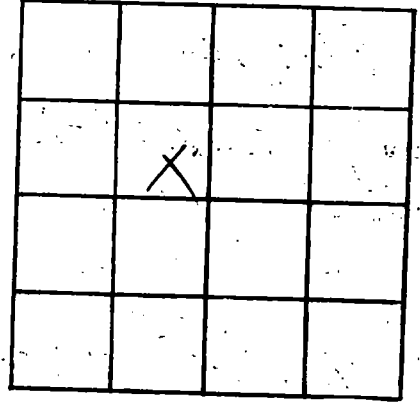

SECTION _____

Please indicate well location X.

ADDITIONAL INFORMATION

If more than one screen, show locations of each on sketch.