

HARRISON
M 559
10-23-72

MISSISSIPPI
 BOARD OF WATER COMMISSIONERS
 416 North State Street
 Jackson, Mississippi 39201


WATER WELL DRILLERS LOG

10-23 1972 Switzer Well Co. HARRISON
 date well completed firm name county well located

LANDOWNER	description of formations encountered	from	to
<u>Smallwood Builders Inc</u>	<u>clay</u>	<u>0</u>	<u>15</u>
<u>2900 22nd Ave.</u>	<u>sand</u>	<u>15</u>	<u>46</u>
<u>Yuleport, Miss. 39501</u>	<u>clay</u>	<u>46</u>	<u>120</u>
(mailing address)	<u>soft clay</u>	<u>120</u>	<u>139</u>
WELL LOCATION:	<u>clay</u>	<u>139</u>	<u>159</u>
sec. <u>16</u> T. <u>7</u> S. R. <u>9</u>	<u>fine sand</u>	<u>159</u>	<u>178</u>
<u>1</u> miles <u>North</u> of <u>Biloxi</u>	<u>Sand</u>	<u>178</u>	<u>198</u>
(distance) (direction) (nearest town)	<u>fine sand</u>	<u>198</u>	<u>217</u>
WELL PURPOSE: <u>firestone stone</u>	<u>fine sand</u>	<u>217</u>	<u>237</u>
(home, irrigation, municipal, industrial)	<u>fine sand</u>	<u>237</u>	<u>257</u>
WELL COMPLETION DATA:	<u>Well Set at 241 feet</u>		
(1) diameter (inches) <u>2"</u>			
(2) total depth (feet) <u>241'</u>			
(3) static water level (feet) <u>16'6"</u> <u>below</u> top of ground.			
(4) casing <u>galv.</u> , <u>241'</u> , (material) (depth)			
(size) if telescope see back.			
(5) screen <u>10</u> , <u>231'</u> (length) (depth to top)			
<u>008</u> , <u>stainless steel</u> (size) (material)			
(6) pump <u>1/2</u> , <u>5</u> (HP) (yield gpm)			
<u>Electric</u> (type power)			
(7) electric log <u>NO</u> (yes or no)			
(organization running log)			
(8) how well bottom plugged <u>back</u> <u>pressure valve</u>			
DRILLERS REMARKS:			

If well telescopes please sketch and show depths.

GROUND LEVEL

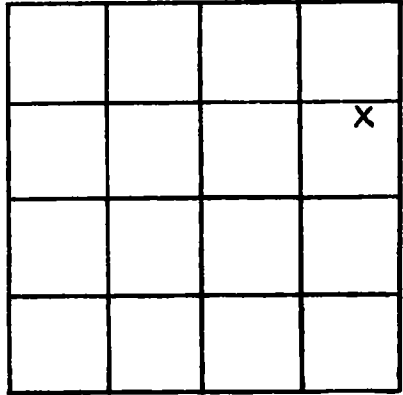

SECTION 16

Please indicate well location X.

ADDITIONAL INFORMATION

If more than one screen, show locations of each on sketch.