

**HARRISON**  
**M 570**  
**11-30-72**

MISSISSIPPI  
 BOARD OF WATER COMMISSIONERS  
 416 North State Street  
 Jackson, Mississippi 39201  
**WATER WELL DRILLERS LOG**

**CODED**

11-30 1972 Scotty Well Co Harrison  
 date well completed firm name county well located

LANDOWNER: Appliance Mart  
453 Central Ave.  
North Biloxi, Miss.  
 (mailing address)

WELL LOCATION:  
 sec. 14 T. 4 N. R. 9 W.  
S W  
1 miles N of Biloxi  
 (distance) (direction) (nearest town)

WELL PURPOSE: Commercial  
 (home, irrigation, municipal, industrial)

- WELL COMPLETION DATA:
- (1) diameter (inches) 2
- (2) total depth (feet) 872'
- (3) static water level (feet) 16'9" below above top of ground.
- (4) casing galv. 872  
 (material) (depth)
- 4 if telescope see back.  
 (size)
- (5) screen 20' 852  
 (length) (depth to top)
- 008 stainless steel  
 (size) (material)
- (6) pump 1 20  
 (HP) (yield gpm)
- ELECT  
 (type power)
- (7) electric log No  
 (yes or no)
- (organization running log)
- (8) how well bottom plugged Jack  
pressure valve

description of formations encountered	from	to
clay	0	20
mixed	20	40
clay	40	76
sand	76	80
mixed	80	90
clay	90	160
fine sand	160	175
clay	175	180
fine sand	180	194
mixed	194	199
fine sand	199	217
clay	217	249
sand	249	254
clay	254	416
clay + shale	416	435
clay	435	515
sand	515	523
clay	523	535
clay + shale	535	554
clay	554	629
sand	629	634
clay	634	787
sand	787	792
fine sand	792	812
fair sand	812	832
good sand	832	872

**CODED**

DEC 20 1972

DRILLERS REMARKS:

If well telescopes please sketch and show depths.

GROUND LEVEL

4" GALV.

127'


BELL REDUCER

2" GALV.

852'

2" STAINLESS  
STEEL W/AR  
WAPPED  
WELL SCREEN

872'

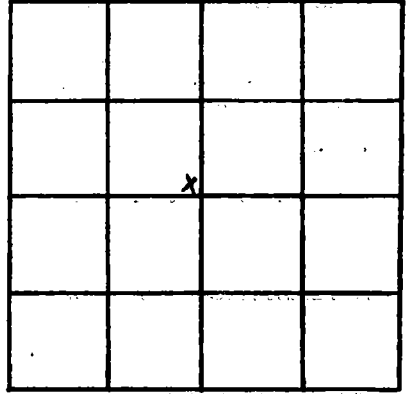

SECTION 16

Please indicate well location X.

ADDITIONAL INFORMATION

If more than one screen, show locations of each on sketch.