

HARRISON  
M 571  
1-3-73

MISSISSIPPI  
BOARD OF WATER COMMISSIONERS  
416 North State Street  
Jackson, Mississippi 39201

**CODED**

WATER WELL DRILLERS LOG

1-3 1973 Switzer Well Co. Harrison  
date well completed firm name county well located

LANDOWNER: Richard Hoff  
Seymour Ave  
Biloxi, Miss 39532  
(mailing address)

description of formations encountered	from	to
clay-sand mixed	0	45
clay-sand streaks	45	66
clay	66	130
clay-sand mixed	130	151
sand, fine	151	194

WELL LOCATION:  
sec. 16 T 7 S R 9 W  
1 miles N of Biloxi  
(distance) (direction) (nearest town)

WELL PURPOSE:  
(home, irrigation, municipal, industrial)

- WELL COMPLETION DATA:
- (1) diameter (inches) 2"
  - (2) total depth (feet) 194'
  - (3) static water level (feet) 21' <sup>below</sup> <sub>above</sub> top of ground.
  - (4) casing galv. 194'  
(material) (depth)
  - if telescope see back.  
(size)
  - (5) screen 10' 184'  
(length) (depth to top)  
006 stainless steel  
(size) (material)
  - (6) pump 1 10  
(HP) (yield gpm)  
Electric  
(type power)
  - (7) electric log no  
(yes or no)  
          
(organization running log)
  - (8) how well bottom plugged back  
pressure valve


**DATE**

FEB 10 1973

DRILLERS REMARKS:

If well telescopes please sketch and show depths.

GROUND LEVEL

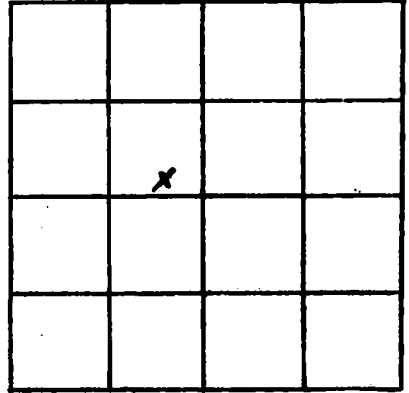

SECTION 16

Please indicate well location X.

ADDITIONAL INFORMATION

If more than one screen,  
show locations of each on sketch.