

HARRISON
M 574
1-11-73

MISSISSIPPI
 BOARD OF WATER COMMISSIONERS
 416 North State Street
 Jackson, Mississippi 39201
WATER WELL DRILLERS LOG

CODEP

1-11-1973 date well completed
 Switzer Well Co. firm name
 Harrison county well located

LANDOWNER: L.A. Easterling Co, Inc
John Dinning Oak
Mockingbird Lane
Gulfport, Miss.
 (mailing address)

WELL LOCATION:
 sec 32 T 7 S R 10 W
6 miles E of Gulfport
 (distance) (direction) (nearest town)



WELL PURPOSE: Home
 (home, irrigation, municipal, industrial)

- WELL COMPLETION DATA:
- diameter (inches) 3
 - total depth (feet) 857'
 - static water level (feet) 195' (below top of ground)
 - casing galv. (material), 857' (depth)
4 (size) if telescope see back.
 - screen 20 (length), 837' (depth to top)
008 (size), Stainless Steel (material)
 - pump 3 (HP), 25 (yield gpm)
electric (type power)
 - electric log no (yes or no)
 (organization running log)
 - how well bottom plugged back
pressure valve

description of formations encountered	from to	
<u>blue sand</u>	0	20
<u>sand</u>	20	35
<u>soft clay</u>	35	40
<u>sand + soft clay</u>	40	60
<u>clay</u>	60	155
<u>sand</u>	155	160
<u>Mud</u>	160	165
<u>clay</u>	165	180
<u>shale</u>	180	199
<u>clay</u>	199	209
<u>shale</u>	209	219
<u>clay</u>	219	334
<u>shale</u>	334	349
<u>clay</u>	349	387
<u>shale</u>	387	397
<u>clay</u>	397	684
<u>shale</u>	684	689
<u>clay</u>	689	714
<u>clay + sand</u>	714	733
<u>clay</u>	733	752
<u>clay + shale</u>	752	773
<u>clay</u>	773	793
<u>fine sand</u>	793	813
<u>good sand</u>	813	857

DRILLERS REMARKS:

If well telescopes please sketch and show depths.

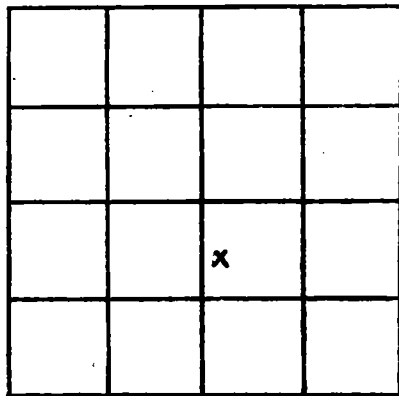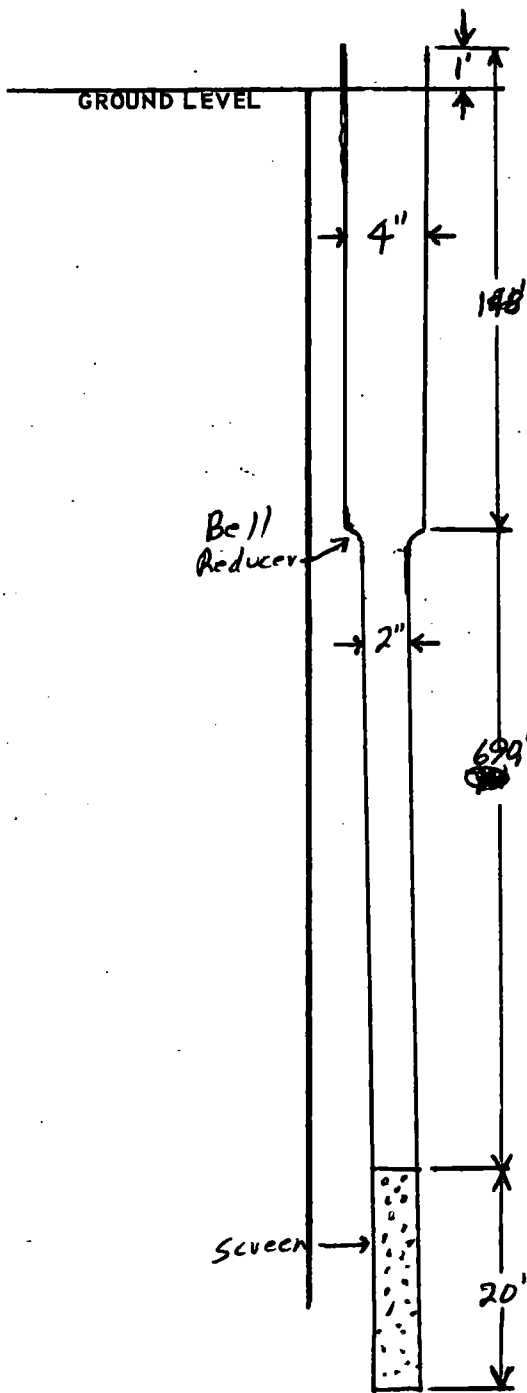

SECTION 32

Please indicate well location X.

ADDITIONAL INFORMATION

If more than one screen, show locations of each on sketch.