

HARRISON
M 575
1-17-73

MISSISSIPPI
 BOARD OF WATER COMMISSIONERS
 416 North State Street
 Jackson, Mississippi 39201

CODED

WATER WELL DRILLERS LOG

1-17 1973 Swidges Well Co. Harrison
 date well completed firm name county well located

LANDOWNER North Biloxi Inv. Co.
(for Bugen Stake)
P.O. Bx 411

Biloxi, Miss.
 (mailing address)

WELL LOCATION:

sec. 16 T 7 S R. 9 W.
20 miles N of Biloxi
 (distance) (direction) (nearest town)

WELL PURPOSE:

(home, irrigation, municipal, industrial)

WELL COMPLETION DATA:

- (1) diameter (inches) 2" ~~2 1/2"~~
- (2) total depth (feet) 896'
- (3) static water level (feet) 2' below top of ground. above
- (4) casing galv. 896'
 (material) (depth)
4" If telescope see back.
 (size)
- (5) screen 20' 876'
 (length) (depth to top)
10'-006
10'-008 (size) stainless steel (material)
- (6) pump 1 22
 (HP) (yield gpm)
electric
 (type power)
- (7) electric log no
 (yes or no)

(organization running log)

- (8) how well bottom plugged hard
pressure valve


DRILLERS REMARKS:

description of formations encountered	from	to
clay	0	47
fine sand	47	66
clay-sand str	66	87
clay	87	126
sand	126	128
clay	128	129
clay-sand str.	129	150
clay	150	169
sand & st.	168	171
clay-sand str.	171	193
clay	193	198
sand	198	200
clay	200	344
fine sand	344	369
clay	369	449
clay-sand str.	449	470
clay	470	514
clay-sand str.	514	534
clay	535	540
fine sand	540	571
clay	571	599
clay-sand str.	599	620
clay	620	704
fine sand	704	725
clay	725	735
fine sand	735	828
clay	828	849
fine sand	849	875
fine sand	875	896

CODED

If well telescopes please sketch and show depths.

GROUND LEVEL

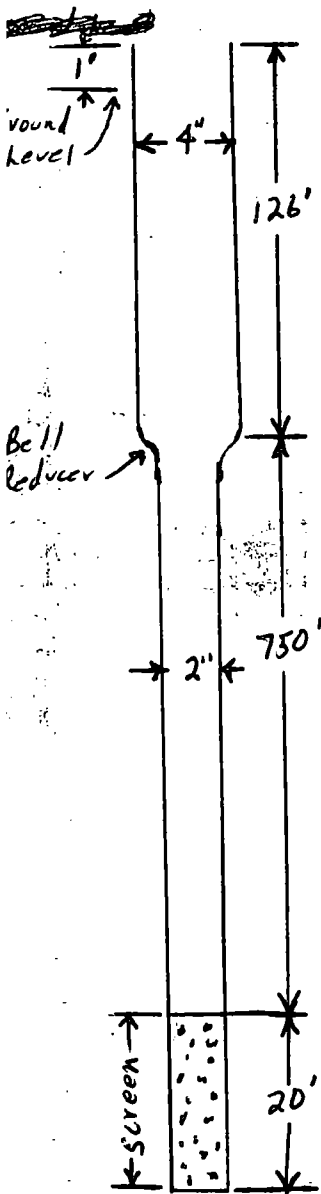

		X	

SECTION 16

Please indicate well location X.

ADDITIONAL INFORMATION

If more than one screen, show locations of each on sketch.