

X

HARRISON
M 581
1-5-73

MISSISSIPPI
BOARD OF WATER COMMISSIONERS
416 North State Street
Jackson, Mississippi 39201

CODED

WATER WELL DRILLERS LOG

COASTAL DRILLING & SERVICE CO.
ROUTE 1 BOX 618

Dorion
county well located

1/5 1973
date well completed

LANDOWNER: Standard Oil
N Bilal, Min
(mailing address)

WELL LOCATION:
sec 23 T 7 N R 9 E
Sherrille of (nearest town)
(distance) (direction)

WELL PURPOSE: Domestic
(home, irrigation, municipal, industrial)

WELL COMPLETION DATA:

- (1) diameter (inches) 2"
- (2) total depth (feet) 440'
- (3) static water level (feet) 39' below top of ground
- (4) casing glau. 430'
(material) (depth)
- (size) If telescope see back.
- (5) screen 10' 430'
(length) (depth to top)
- 2" S.S.
(size) (material)
- (6) pump One 16
(HP) (yield gpm)
- Ele
(type power)
- (7) electric log No
(yes or no)
- yes
(organization running log)
- (8) how well bottom plugged 2" threaded pipe

Description of formations encountered	from	to
Top Soil	1	2
Red Clay	2	5
Sugar Sand	5	26
Coarse Water Sand	26	35
Brown Sand	35	45
Soft Blue Clay	45	78
White Sand	78	85
Soft Brown Clay	85	100
Blue Clay	100	230
fine water sand	230	270
hard blue clay	270	285
fine water sand	285	380
hard blue clay	380	420
fine water sand	420	440
Coarse Water Sand	440	440


DRILLERS REMARKS:

DRILLERS REMARKS:

None

If well telescopes please
sketch and show depths.

GROUND LEVEL

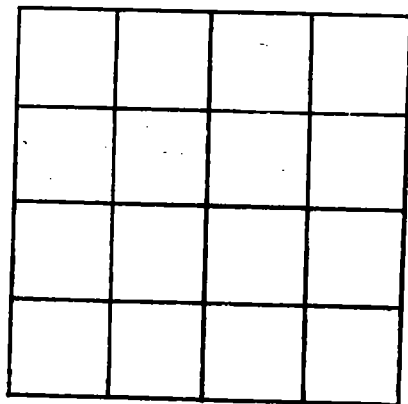

SECTION _____

Please indicate well location X.

ADDITIONAL INFORMATION

If more than one screen,
show locations of each on sketch.