

HARRISON
M 584
6-22-71

MISSISSIPPI
 BOARD OF WATER COMMISSIONERS
 416 North State Street
 Jackson, Mississippi 39201

CODED

WATER WELL DRILLERS LOG


June 22 1971 McGee well works Harrison
 date well completed firm name county well located

LANDOWNER: MR. Yarbrough	description of formations encountered	from	to
Edgewater Park			
Biloxi (mailing address)	topsoil Sand	0	2
WELL LOCATION:			
sec 34 T 7 N R 10 E 8 miles E of Gulfport (distance) (direction) (nearest town)			
WELL PURPOSE: Irrigation (home, irrigation, municipal, industrial)			
WELL COMPLETION DATA:			
(1) diameter (inches) 2"			
(2) total depth (feet) 30'			
(3) static water level (feet) 3' below top of ground			
(4) casing Plastic 20' (material) (depth)			
_____ (size) if telescope see back.			
(5) screen 10' (length) (depth to top)			
2" plastic (size) (material)			
(6) pump 1/2 8 (HP) (yield gpm)			
Electric (type power)			
(7) electric log NO (yes or no)			
_____ (organization running log)			
(8) how well bottom plugged sand shank			
DRILLERS REMARKS:			
MAY 29 1973			

CODED

If well telescopes please sketch and show depths.

GROUND LEVEL

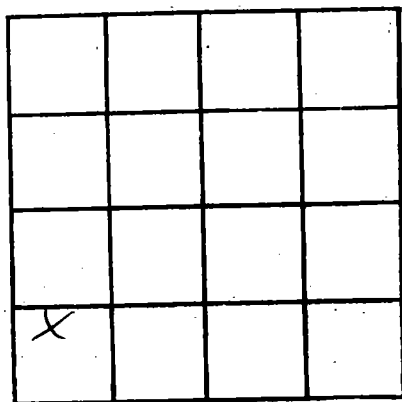

SECTION 34

Please indicate well location X.

ADDITIONAL INFORMATION

If more than one screen, show locations of each on sketch.