

HARRISON  
M 585  
12-1-71

MISSISSIPPI  
 BOARD OF WATER COMMISSIONERS  
 416 North State Street  
 Jackson, Mississippi 39201

**CODED**

WATER WELL DRILLERS LOG

12/1 1971 McGill well works Harrison  
 date well completed firm name county well located

LANDOWNER: W.P. Hillabrant  
821 Hardy ave.  
Huffport  
 (mailing address)

description of formations encountered from to  
Sand 0 30

WELL LOCATION:  
 sec 8 T 8 N R 10 E  
Blue S W  
2 miles E of Huffport  
 (distance) (direction) (nearest town)

WELL PURPOSE: Irrigation  
 (home, irrigation, municipal, industrial)

- WELL COMPLETION DATA:
- (1) diameter (inches) 2"
  - (2) total depth (feet) 30'
  - (3) static water level (feet) 3' below top of ground. above
  - (4) casing plastic 20'  
 (material) (depth)  
         if telescope see back.  
 (size)
  - (5) screen 10'  
 (length) (depth to top)  
2" plastic  
 (size) (material)
  - (6) pump 1/2 9  
 (HP) (yield gpm)  
electric  
 (type power)
  - (7) electric log no  
 (yes or no)  
 (organization running log)
  - (8) how well bottom plugged sand  
shark


**CODED**

DRILLERS REMARKS:         

29 1973

614  
If well telescopes please sketch and show depths.

GROUND LEVEL

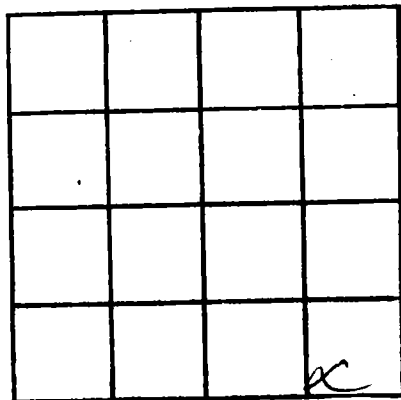

SECTION *in*

Please indicate well location X. *Blue*

ADDITIONAL INFORMATION

If more than one screen, show locations of each on sketch.