

HARRISON  
M 586  
9-4-71

MISSISSIPPI  
BOARD OF WATER COMMISSIONERS  
416 North State Street  
Jackson, Mississippi 39201

**CODED**

WATER WELL DRILLERS LOG

9/4 1971 McGil well works Harrison  
date well completed firm name county well located

LANDOWNER:	description of formations encountered	from	to
A.V. Thompson			
1239-24th. Haysport (mailing address)	clay	2	6
	purple sand	6	26

WELL LOCATION:  
sec. 8 T. 2 N. R. 12 E.  
Blue S. W  
2 miles E of L.B.  
(distance) (direction) (nearest town)

WELL PURPOSE: Irrigation  
(home, irrigation, municipal, industrial)

- WELL COMPLETION DATA:
- (1) diameter (inches) 1 1/4"
  - (2) total depth (feet) 29'
  - (3) static water level (feet) 3" below above top of ground.
  - (4) casing gal. 18'  
(material) (depth)
  - (size) if telescope see back.
  - (5) screen 10' 14"  
(length) (depth to top)  
(size) 5.5 (material)
  - (6) pump 1 9  
(HP) (yield gpm)  
electric  
(type power)
  - (7) electric log no  
(yes or no)
  - (organization running log)
  - (8) how well bottom plugged sand  
plank


**CODED**

JULY 29 1973

DRILLERS REMARKS:

If well telescopes please  
sketch and show depths.

GROUND LEVEL

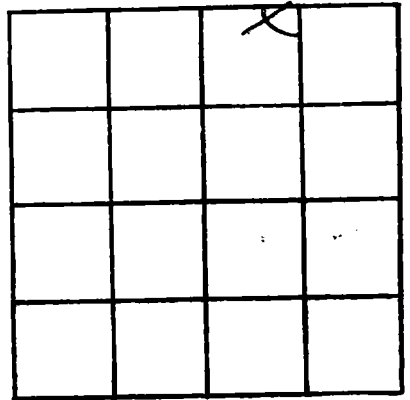

SECTION *in Blue*

Please indicate well location X.

ADDITIONAL INFORMATION

If more than one screen,  
show locations of each on sketch.