

HARRISON
M 591
6-11-73

MISSISSIPPI
 BOARD OF WATER COMMISSIONERS
 416 North State Street
 Jackson, Mississippi 39201

CODED

WATER WELL DRILLERS LOG

6-11 1973 Switzer Well Co. Harrison
 date well completed firm name county well located

LANDOWNER: Marshall Johnson
417 Church Ave
Biloxi, Miss.
 (mailing address)

WELL LOCATION:
 sec. 28 T. 7 S. R. 9 W.
1 miles N of Biloxi
 (distance) (direction) (nearest town)

WELL PURPOSE: home
 (home, irrigation, municipal, industrial)

WELL COMPLETION DATA:

(1) diameter (inches) 2"

(2) total depth (feet) 895'

(3) static water level (feet) 5' below
 top of ground.

(4) casing galv. 895'
 (material) (depth)
4" if telescope see back.
 (size)

(5) screen 20' 875'
 (length) (depth to top)
008 Stainless steel
 (size) (material)

(6) pump Owners
 (HP) (yield gpm)

(type power)

(7) electric log No
 (yes or no)

(organization running log)

(8) how well bottom plugged back
pressure valve

description of formations encountered	from	to
clay	0	15
streaks	15	20
clay	20	45
sand	45	60
clay	60	75
sand	75	80
mud	80	100
clay	100	120
shail + clay	120	160
clay	160	180
fine sand	180	188
mud	188	200
clay	200	319
sand, fine	319	353
clay	353	547
sand, CODED	547	567
clay	567	706
mud	706	746
clay	746	756
clay-streaks	756	766
sand	766	776
sand, fine	776	816
mud	816	825
sand	825	855
sand, fine	855	875
sand, fine	875	895
mud	895	908


(Well set at 895 feet.)

DRILLERS REMARKS:

JUN 20 1973

If well telescopes please sketch and show depths.

GROUND LEVEL

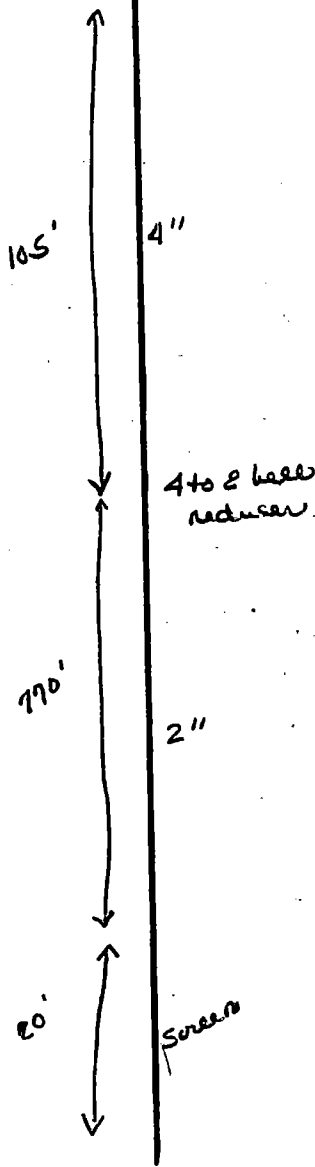

X			

SECTION 28

Please indicate well location X.

ADDITIONAL INFORMATION

If more than one screen, show locations of each on sketch.