

HARRISON  
M 594  
7-23-73

MISSISSIPPI  
BOARD OF WATER COMMISSIONERS  
416 North State Street  
Jackson, Mississippi 39201

**CODED**

WATER WELL DRILLERS LOG

June 6 1973 McGill Well Works Harrison  
 (date well completed) (firm name) (county well located)

LANDOWNER: John Mello  
 Hwy. 90 Edgewater  
 Biloxi, Miss.  
 (mailing address)

description of formations encountered	from	to
sand	0	30

WELL LOCATION:  
 sec. 24 T. 7 N R. 10 E  
 7 miles E of Biloxi  
 (distance) (direction) (nearest town)

WELL PURPOSE: Irrigation  
 (home, irrigation, municipal, industrial)

- WELL COMPLETION DATA:
- (1) diameter (inches) 2"
  - (2) total depth (feet) 30'
  - (3) static water level (feet) 3' below top of ground.
  - (4) casing plastic 20' (material) (depth)  
 (size) If telescope see back.
  - (5) screen 10' (length) (depth to top)  
 2" (size) plastic (material)
  - (6) pump 1/2 (HP) 10 (yield gpm)  
 Electric (type power)
  - (7) electric log NO (yes or no)
  - (organization running log)
  - (8) how well bottom plugged plug


**CODED**

DRILLERS REMARKS:

JUL 19 1973

If well telescopes please sketch and show depths.

GROUND LEVEL

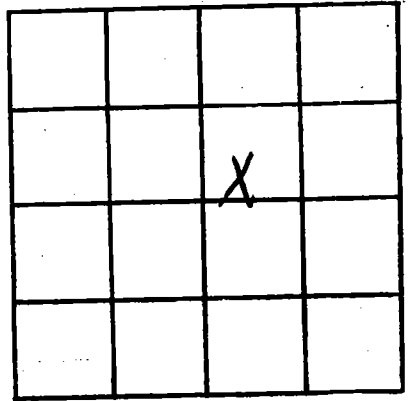

SECTION 34

Please indicate well location X.

ADDITIONAL INFORMATION

If more than one screen, show locations of each on sketch.