

HARRISON
M 596
6-25-73

MISSISSIPPI
BOARD OF WATER COMMISSIONERS
416 North State Street
Jackson, Mississippi 39201

INDEXED

WATER WELL DRILLERS LOG

6-25 1973
date well completed

Switzer Drill Co
firm name


Harrison
county well located

| LANDOWNER: <u>P. U. Ellis</u> | description of formations encountered | from | to |
|-------------------------------------------------------------------------|---------------------------------------|------|-----|
| <u>222 Bead Ave.</u> | | | 0 |
| <u>N. Biloxi Miss. 39532</u> | | 95 | 107 |
| (mailing address) | | 107 | 225 |
| | | 225 | 236 |
| WELL LOCATION: | | 236 | 249 |
| sec. <u>22</u> T. <u>7</u> S. R. <u>9</u> W. | | 249 | 259 |
| <u>1</u> miles <u>N</u> of <u>Biloxi</u> | | 259 | 382 |
| (distance) (direction) (nearest town) | | 332 | 364 |
| WELL PURPOSE: <u>home</u> | | | |
| (home, irrigation, municipal, industrial) | | | |
| WELL COMPLETION DATA: | | | |
| (1) diameter (Inches) <u>2"</u> | | | |
| (2) total depth (feet) <u>364'</u> | | | |
| (3) static water level (feet) <u>41'</u> <u>below</u> top of ground. | | | |
| (4) casing <u>galv.</u> <u>364'</u> (material) (depth) | | | |
| (size) if telescope see back. | | | |
| (5) screen <u>10</u> <u>354'</u> (length) (depth to top) | | | |
| <u>008</u> <u>stainless steel</u> (size) (material) | | | |
| (6) pump <u>1/2</u> <u>5</u> (HP) (yield gpm) | | | |
| <u>electric</u> (type power) | | | |
| (7) electric log <u>no</u> (yes or no) | | | |
| (organization running log) | | | |
| (8) how well bottom plugged <u>back</u> <u>pressure valve</u> | | | |
| DRILLERS REMARKS: | | | |

JUL 30 1973

If well telescopes please sketch and show depths.

GROUND LEVEL

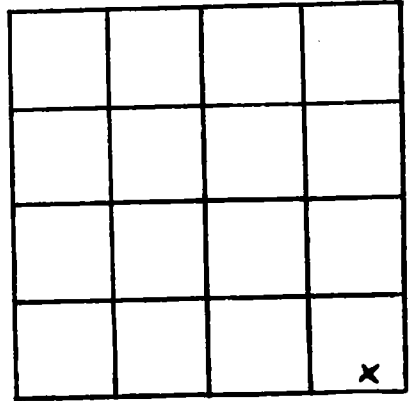

SECTION 22

Please indicate well location X.

ADDITIONAL INFORMATION

If more than one screen,
show locations of each on sketch.