

HARRISON

M 598

6-30-73

MISSISSIPPI BOARD OF WATER COMMISSIONERS  
416 North State Street  
Jackson, Mississippi 39201

CODED

WATER WELL DRILLERS LOG

6-30 1973  
date well completed

Switzer Well Co.  
firm name

Harrison  
county well located

LANDOWNER: Burger King Rest.

Hwy 90

Bidopi Miss.

(mailing address)

description of formations encountered

from

to

Clay

0 34

Clay

34 40

sand

40 50

Clay

50 74

mixed

74 80

Clay

80 160

Clay-sand str.

160 179

Sand

179 184

Clay

184 238

Soft clay

238 258

Sand

258 268

Clay

268 442

Sand

442 454

Clay

454 575

Mixed fine sand

575 595

fine sand

595 154

hard sand

654 674

Ultra good sand

674 713

sand

713 730

WELL LOCATION:

sec 36 T 7 N R 12 E  
S W  
1/4 miles City of Bil  
(distance) (direction) (nearest town)

WELL PURPOSE:

(home, irrigation, municipal, industrial)

WELL COMPLETION DATA:

- (1) diameter (inches) 2
- (2) total depth (feet) 730 feet
- (3) static water level (feet) 38.6' <sup>below</sup> top of ground
- (4) casing galv. 730 (material) (depth)  
4 (size) if telescope see back.
- (5) screen 20 710 (length) (depth to top)  
008 stainless steel (size) (material)
- (6) pump 1 (subm) 27 (HP) (yield gpm)  
electric (type power)
- (7) electric log no (yes or no)

(organization running log)

(8) how well bottom plugged  
free  
pressure valve


DRILLERS REMARKS:

AUG 1 1973

MISS. BD. OF WATER COMF.

If well telescopes please sketch and show depths.

GROUND LEVEL

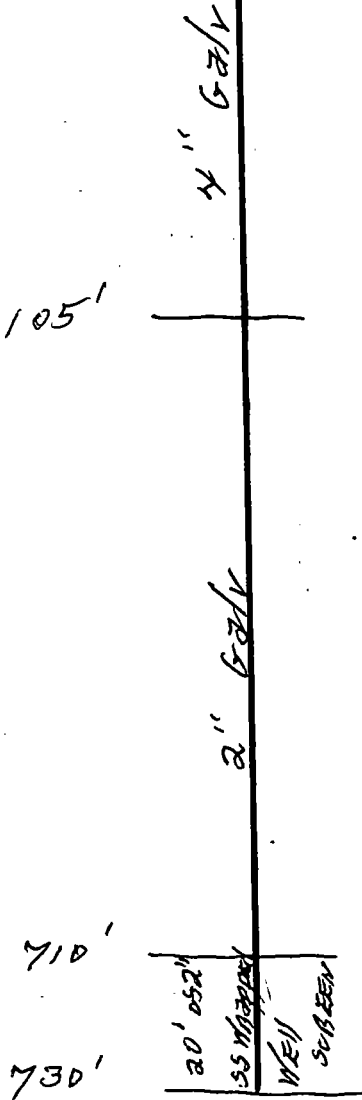

X			

SECTION 36

Please indicate well location X.

ADDITIONAL INFORMATION

If more than one screen, show locations of each on sketch.