

Harrison  
M 601  
6-26-73

MISSISSIPPI  
BOARD OF WATER COMMISSIONERS  
416 North State Street  
Jackson, Mississippi 39201

CODED

WATER WELL DRILLERS LOG

June 26 1973 Mc Gill well works Harrison  
date well completed firm name county well located

LANDOWNER: Mr. Roberts  
636 Seal Ave.  
Biloxi, Miss.  
(mailing address)

description of formations encountered	from	to
	sand	0

WELL LOCATION:  
sec. 25 T. 2 N. R. 10 E  
4 miles W. of Biloxi  
(distance) (direction) (nearest town)

WELL PURPOSE: municipal  
(home, irrigation, municipal, industrial)

- WELL COMPLETION DATA:
- (1) diameter (inches) 2"
  - (2) total depth (feet) 30'
  - (3) static water level (feet) 3 1/2' below top of ground.
  - (4) casing plastic, 20' (material) (depth)  
if telescope see back.
  - (5) screen 10' (length) (depth to top)  
2" plastic (size) (material)
  - (6) pump 1/2 HP, 12 (yield gpm)  
Electric (type power)
  - (7) electric log no (yes or no)  
(organization running log)
  - (8) how well bottom plugged plug


CODED

DRILLERS REMARKS:

SEP 10 1973

If well telescopes please sketch and show depths.

GROUND LEVEL

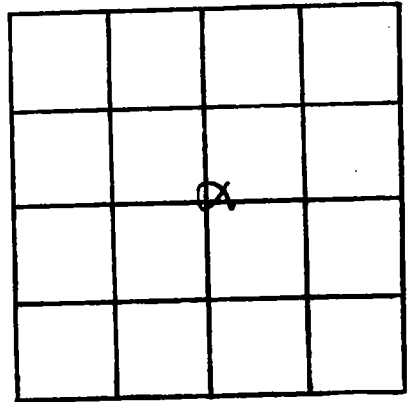

SECTION 25

Please indicate well location X.

ADDITIONAL INFORMATION

If more than one screen, show locations of each on sketch.