

Harrison
M 603
4-13-73

MISSISSIPPI
BOARD OF WATER COMMISSIONERS
416 North State Street
Jackson, Mississippi 39201

CODED

WATER WELL DRILLERS LOG

April 13 1973 Mc Gill well works Harrison
date well completed firm name county well located

LANDOWNER:
Mrs. Gisteneck
870 Bleuer Drive
Biloxi (mailing address)

description of formations encountered from to

WELL LOCATION:
sec. 25 T. 7 N. R. 10 E.
4 miles W of Biloxi
(distance) (direction) (nearest town)

Coarse Sand 0 30

WELL PURPOSE: Irrigation
(home, irrigation, municipal, industrial)

WELL COMPLETION DATA:

(1) diameter (inches) 2"

(2) total depth (feet) 30'

(3) static water level (feet) 3' below above top of ground.

(4) casing plastic, 20'
(material) (depth)
(size) If telescope see back.

(5) screen 10'
(length) (depth to top)
2" plastic
(size) (material)

(6) pump 1/2 12
(HP) (yield gpm)
electric
(type power)

(7) electric log no
(yes or no)
(organization running log)

(8) how well bottom plugged Sand
shark


CODED

DRILLERS REMARKS:

SEP 10 1973

If well telescopes please sketch and show depths.

GROUND LEVEL

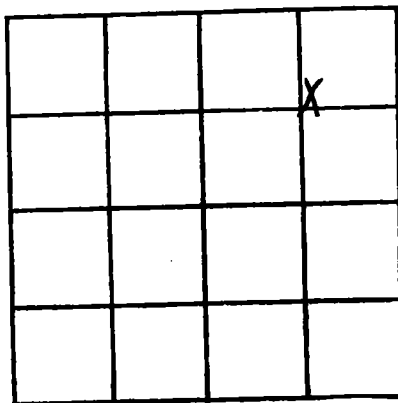

SECTION 25

Please indicate well location X.

ADDITIONAL INFORMATION

If more than one screen,
show locations of each on sketch.