

Harrison
 M604
 7-30-73

MISSISSIPPI
 BOARD OF WATER COMMISSIONERS
 416 North State Street
 Jackson, Mississippi 39201

CODED

WATER WELL DRILLERS LOG
 COASTAL DRILLING & SERVICE CO.

Harrison
 county well located

7/30 1973
 date well completed

ROUTE 1 BOX 618

LANDOWNER: *Hary Rosetti*
Biloxi, Miss
 (mailing address)

description of formations encountered	from	to
Top Soil	1	3
Yellow Sand	3	20
Red Sand	20	35
White Sand	35	90
Soft Clay Sand	90	220
fine water Sand	220	235
hard Blue Clay	235	320
fine water Sand	320	330
Coarse water Sand	330	360

WELL LOCATION:
 sec. 7 T. 2 R. 9
 1 1/2 miles (distance) N Biloxi (direction) of (nearest town)

WELL PURPOSE: *home*
 (home, irrigation, municipal, industrial)

WELL COMPLETION DATA:

(1) diameter (inches) 2"

(2) total depth (feet) 360'

(3) static water level (feet) 32 below above top of ground.

(4) casing glad (material), 350' (depth)
 (size) If telescope see back.

(5) screen 10' (length), 350' (depth to top)
2" (size), S.S. (material)

(6) pump One (HP), 17 (yield gpm)
Ele (type power)

(7) electric log no (yes or no)

(organization running log)

CODED

(8) how well bottom plugged
2" black tarred well


DRILLERS REMARKS:
None

SEP 7 1973

MISS. BOARD OF WATER COMMISSIONERS

If well telescopes please sketch and show depths.

GROUND LEVEL

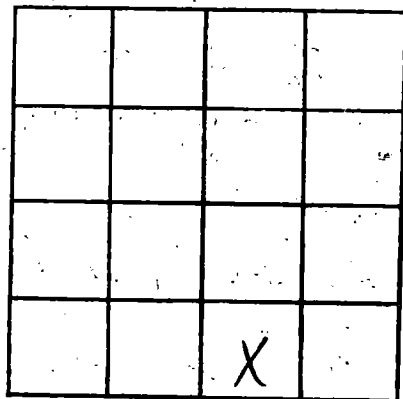

SECTION _____

Please indicate well location X.

ADDITIONAL INFORMATION

If more than one screen, show locations of each on sketch.