

Harrison
M 607
5-12-73

MISSISSIPPI
BOARD OF WATER COMMISSIONERS
416 North State Street
Jackson, Mississippi 39201

CODED

WATER WELL DRILLERS LOG
COASTAL DRILLING & SERVICE CO.

Harrison
county well located

5/12/73
date well completed

ROUTE 1 BOX 618

LANDOWNER: *John Chatham*
Biloxi, MISS.

North Biloxi Drive
(mailing address)

WELL LOCATION:
sec. *9* T. *7* N. R. *9* E
O'Learyville
(distance) (direction) (nearest town)

WELL PURPOSE: *home*
(home, irrigation, municipal, industrial)

WELL COMPLETION DATA:

- (1) diameter (inches) 2"
- (2) total depth (feet) 643'
- (3) static water level (feet) 12 below above-top of ground.
- (4) casing slat 633'
(material) (depth)
- (5) screen 10' 633'
(length) (depth to top)
2" S.S.
(size) (material)
- (6) pump one 17
(HP) (yield gpm)
Elec
(type power)
- (7) electric log no
(yes or no)
- (organization running log)

(8) how well bottom plugged
2" horizontal valves

DRILLERS REMARKS:
Very good well

description of formations encountered	from	to
<i>Top Soil</i>	<i>1</i>	<i>2</i>
<i>Red Clay</i>	<i>2</i>	<i>15</i>
<i>White Sand</i>	<i>15</i>	<i>46</i>
<i>Soft Blue Clay</i>	<i>46</i>	<i>300</i>
<i>Hard Blue Clay</i>	<i>300</i>	<i>340</i>
<i>Shells</i>	<i>340</i>	<i>350</i>
<i>hard Blue Clay</i>	<i>350</i>	<i>465</i>
<i>fine Blue Clay</i>	<i>465</i>	<i>560</i>
<i>fine water sand</i>	<i>560</i>	<i>600</i>
<i>Coarse water sand</i>	<i>600</i>	<i>643</i>


CODED

SEP 7 1973

MISS. BD. OF
WATER COMMISSIONERS

If well telescopes please sketch and show depths.

GROUND LEVEL

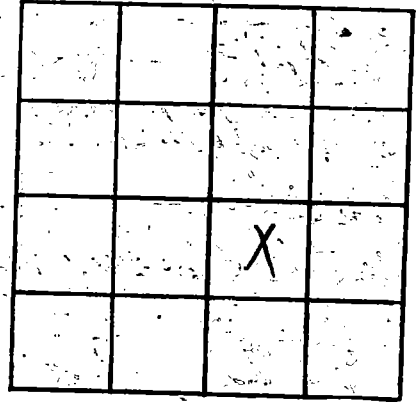

SECTION _____

Please indicate well location X.

ADDITIONAL INFORMATION

If more than one screen, show locations of each on sketch.