

HARRISON
M 611
10-30-73

MISSISSIPPI
BOARD OF WATER COMMISSIONERS
416 North State Street
Jackson, Mississippi 39201

CODED

WATER WELL DRILLERS LOG

10-30 1973 Switzer Well Co. Harrison
date well completed firm name county well located

LANDOWNER Aubrey Herrington

Yee Street

Biola, Miss. 39531
(mailing address)

WELL LOCATION:

sec. 13 T. 7 S. R. 10 W.
2 miles N of Biola
(distance) (direction) (nearest town)

WELL PURPOSE: home
(home, irrigation, municipal, industrial)

WELL COMPLETION DATA:

- (1) diameter (inches) 2"
- (2) total depth (feet) 380'
- (3) static water level (feet) 40' below
top of ground.
- (4) casing galv. 380'
(material) (depth)
4"
(size) if telescope see back.
- (5) screen 20' 360'
(length) (depth to top)
008 stainless steel
(size) (material)
- (6) pump 1 subm 19
(HP) (yield gpm)
elect.
(type power)
- (7) electric log No
(yes or no)
- (organization running log)

(8) how well bottom plugged back
pressure valve

DRILLERS REMARKS:

description of formations encountered


from to

sand	0	9
clay	9	54
fine sand	54	78
clay	78	108
clay-sand str.	108	129
clay	129	296
sand	296	306
clay	306	340
sand	340	379

CODED

NOV 24 1973

If well telescopes please sketch and show depths.

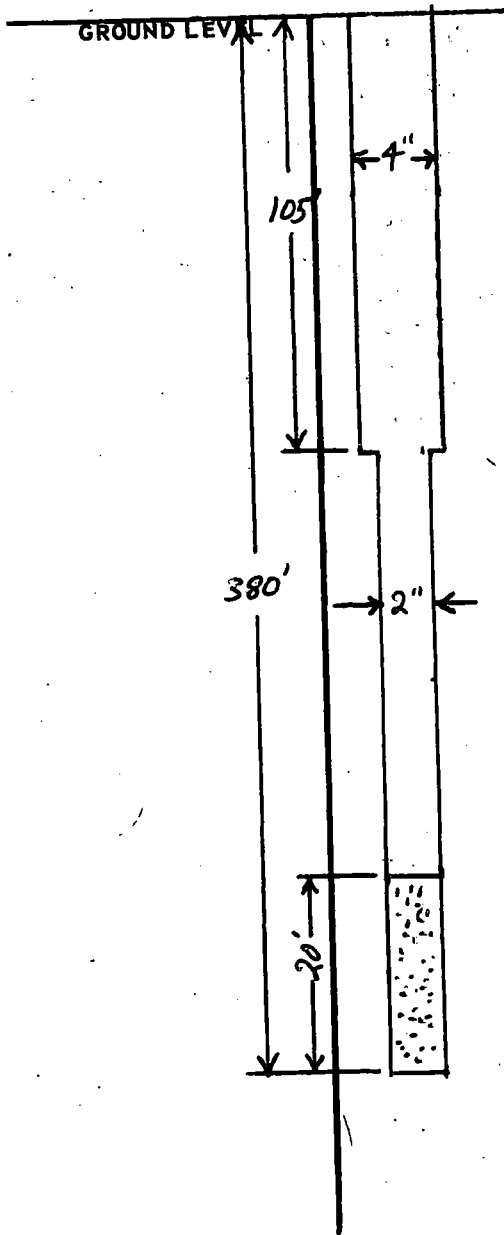

	X		

SECTION 13

Please indicate well location X.

ADDITIONAL INFORMATION

If more than one screen, show locations of each on sketch.