

**HARRISON**  
**M612**  
**12-12-73**  
**E Log # 103**

**MISSISSIPPI**  
**BOARD OF WATER COMMISSIONERS**  
 416 North State Street  
 Jackson, Mississippi 39201

**CODED**

**WATER WELL DRILLERS LOG**

12-12 date well completed      1973 Singer Leys Central Div firm name      Harrison county well located

**LANDOWNER** Naval Ret. Home  
(Terry Feeney, Inc.)  
Gueppert Miss  
 (mailing address)

**WELL LOCATION:**  
 sec. 32 T 7 N      R 10 West  
 (distance) miles (direction) of (nearest town)

**WELL PURPOSE:**  
 (home, irrigation, municipal, industrial)

**WELL COMPLETION DATA:**

(1) diameter (inches) 12"

(2) total depth (feet) 263'

(3) static water level (feet) 23' below top of ground.

(4) casing Steel 800'  
 (material) (depth)

12" If telescope see back.  
 (size) 60' 36"

(5) screen 50' 807'  
 (length) (depth to top)

6" S.S. W.W.  
 (size) (material)

(6) pump 30 330  
 (HP) (yield gpm)

Electric  
 (type power)

(7) electric log Yes  
 (yes or no)  
Miss. Geol. Survey  
 (organization running log)

(8) how well bottom plugged Valve

description of formations encountered	from	to
Sand and Fill Dirt	0	10
Sand and Clay Strands	10	43
Sand	43	78
Clay, Gummy	78	142
Sandy Shale	142	161
Sand	161	173
Clay	173	185
Sand	185	194
Clay	194	198
Sandy Clay	198	238
Sand	238	249
Sandy Shale	249	340
Shale	340	385
Sand	385	416
Clay and Sand Sls.	416	460
Sand, Clay	460	598
Clay	598	651
Clay	651	726
Sandy Clay Sls	726	805
Sand	805	855
Clay	855	896
Clay and Sand Sls	896	954
Sand and Clay Sls.	954	1054

**CODED**

**RECORDED**


JAN 9 1974

**DRILLERS REMARKS:**

MISS. Bd. OF WATER COM.

If well telescopes please sketch and show depths.

GROUND LEVEL

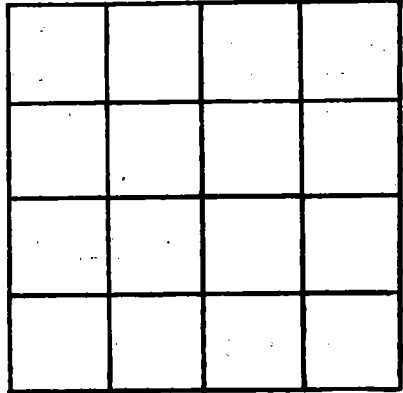

SECTION \_\_\_\_\_

Please indicate well location X.

ADDITIONAL INFORMATION

If more than one screen, show locations of each on sketch.