

**HARRISON**  
**MC14**  
**12-11-73**

**MISSISSIPPI**  
**BOARD OF WATER COMMISSIONERS CODED**  
 416 North State Street  
 Jackson, Mississippi 39201  
**WATER WELL DRILLERS LOG**

12-11-73 Switzer Well Co. Harrison  
 date well completed firm name county well located

**LANDOWNER:** J.C. Chapman  
Creech Circle  
Greensboro, Miss.  
 (mailing address)

**WELL LOCATION:**  
 sec. 19 T-7 R-10  
1 miles E of Greensboro  
 (distance) (direction) (nearest town)

**WELL PURPOSE:** home  
 (home, irrigation, municipal, industrial)

**WELL COMPLETION DATA:**

(1) diameter (inches) 2"

(2) total depth (feet) 301'

(3) static water level (feet) 21' below above top of ground.

(4) casing galv. 301'  
(material) (depth)

       if telescope see back.  
(size)

(5) screen 10' 291'  
(length) (depth to top)  
008, stainless steel  
(size) (material)

(6) pump 1/2 8  
(HP) (yield gpm)  
elec.  
(type power)

(7) electric log no  
(yes or no)

        
(organization running log)

(8) how well bottom plugged back  
pressure valve


description of formations encountered	from	to
clay	0	3
sand	3	23
clay	23	67
sand	67	75
clay	75	144
sand	144	148
clay	148	152
sand, fine	152	205
clay	205	260
sand, fine	260	279
sand, fine	279	301

**JAN 1 1974**

**MISS. BD OF W.**

If well telescopes please sketch and show depths.

GROUND LEVEL

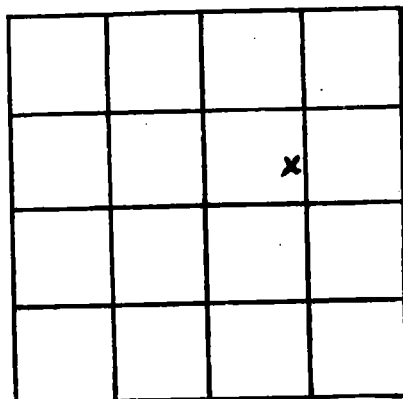

SECTION 19

Please indicate well location X.

ADDITIONAL INFORMATION

If more than one screen,  
show locations of each on sketch.