

HARRISON
M 615
9-20-73

MISSISSIPPI
 BOARD OF WATER COMMISSIONERS
 416 North State Street
 Jackson, Mississippi 39201

WATER WELL DRILLERS LOG

COASTAL DRILLING & SERVICE CO. *Harrison*

9/20 1973
 date well completed

ROUTE 1 ~~Box~~ 618

county well located

LANDOWNER: *Woolmarket Catholic Catchkill Church*
 Rt F Bilecki's Miss
 (mailing address)

BILOXI, MISS 39532

description of formations encountered	from	to
Top Soil	1	3
Red Clay	3	15
Sandy Sand	15	40
White Sand	40	50
Blue Clay	50	78
Brown Sand	78	100
Salt Blue Clay	100	155
Hard Blue Clay	155	300
fine water sand	300	315
hard Blue Clay	315	435
fine water sand	435	460
Coarse water sand	460	500

WELL LOCATION:

sec. 2 T 2 N R 10 E
 S W
Woolmarket
 (distance) miles (direction) of (nearest town)

WELL PURPOSE: *Church*
 (home, irrigation, municipal, industrial)

WELL COMPLETION DATA:

- (1) diameter (inches) 2x4"
- (2) total depth (feet) 500'
- (3) static water level (feet) 45 below top of ground.
- (4) casing Galv 485'
 (material) (depth)
4x2"
 (size) if telescope see back.
- (5) screen 15' 485'
 (length) (depth to top)
2" S.S.
 (size) (material)
- (6) pump one 21
 (HP) (yield gpm)
ele sub
 (type power)
- (7) electric log no
 (yes or no)

CODED

(organization running log)

(8) how well bottom plugged
2" fractured shale

DRILLERS REMARKS:
good well

MISS. BD. OF WATER COMM

If well telescopes please sketch and show depths.

GROUND LEVEL


200' 4" galv Casing

285' 2" galv. Casing

15' 2" S.S. Screen

2" back wash valve

If more than one screen, show locations of each on sketch.

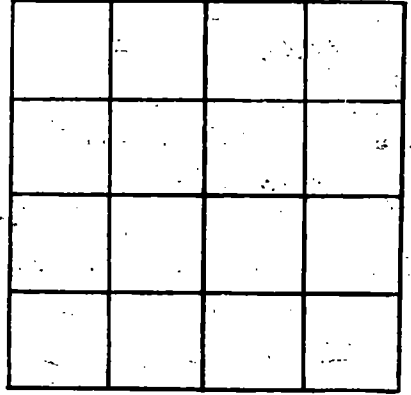

SECTION _____

Please indicate well location X.

ADDITIONAL INFORMATION

Multiple horizontal lines for providing additional information.