

HARRISON
 Shallow well c.
M 617
6-6-73

MISSISSIPPI
 BOARD OF WATER COMMISSIONERS
 416 North State Street
 Jackson, Mississippi 39201

WATER WELL DRILLERS LOG

Jan 6 1973 *Mc Gill well works* Harrison
 date well completed firm name county well located

LANDOWNER: *Ray B. Craig*
 Hwy. 90 Edgewater
 Biloxi, Ms.
 (mailing address)

description of formations encountered

from

sand 0 30


WELL LOCATION:
 sec. 34 T. 7 N. R. 10 W.
8 miles E of Biloxi
 (distance) (direction) (nearest town)

WELL PURPOSE: irrigation
 (home, irrigation, municipal, industrial)

- WELL COMPLETION DATA:
- (1) diameter (inches) 2"
 - (2) total depth (feet) 30'
 - (3) static water level (feet) 6' below top of ground.
 - (4) casing plastic 20'
 (material) (depth)
— (size) If telescope see back.
 - (5) screen 10'
 (length) (depth to top)
2" plastic
 (size) (material)
 - (6) pump 1/2 11
 (HP) (yield gpm)
electric
 (type power)
 - (7) electric log no
 (yes or no)
 - (organization running log)
 - (8) how well bottom plugged plug

CODED

CODED

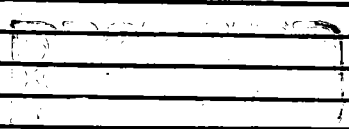

FEB 4 1973

DRILLERS REMARKS:

MISS. BD. OF WATER COMM

If well telescopes please sketch and show depths.

GROUND LEVEL

X			

SECTION 34

Please indicate well location X.

ADDITIONAL INFORMATION

If more than one screen, show locations of each on sketch.