

HARRISON

S.W.

M 625

7-31-73

*copy*

MISSISSIPPI  
BOARD OF WATER COMMISSIONERS  
416 North State Street  
Jackson, Mississippi 39201

WATER WELL DRILLERS LOG

July 31 1973 McNeil Well Works Harrison  
 date well completed firm name county well located

LANDOWNER: Mrs. Burns

2573 Jo Ann

Gulfport, Miss.  
(mailing address)

description of formations encountered

from

to

Sand

0 30

WELL LOCATION:

sec 32 T 7 N R 10 E

2 miles East of Gulfport  
(distance) (direction) (nearest town)

WELL PURPOSE: irrigation  
(home, irrigation, municipal, industrial)

WELL COMPLETION DATA:

- (1) diameter (inches) 2"
- (2) total depth (feet) 30'
- (3) static water level (feet) 4' below above top of ground.

(4) casing plastic 20'  
(material) (depth)

       if telescope see back.  
(size)

(5) screen 10'         
(length) (depth to top)

2" plastic  
(size) (material)

(6) pump 1/2 10  
(HP) (yield gpm)

Electric  
(type power)

(7) electric log No  
(yes or no)

        
(organization running log)

(8) how well bottom plugged Sand  
shark


**CODED**

DRILLERS REMARKS:       

MISS. FD. UP

If well telescopes please sketch and show depths.

GROUND LEVEL

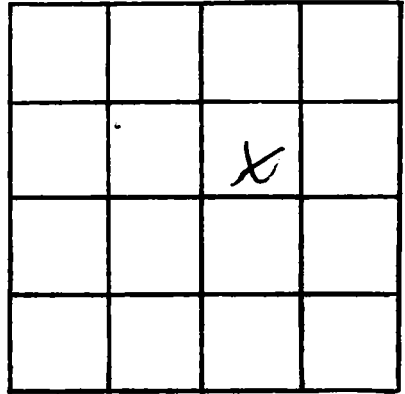

SECTION 32

Please indicate well location X.

ADDITIONAL INFORMATION

If more than one screen,  
show locations of each on sketch.