

S.W.
 M 626
 HARRISON
 8-7-73

MISSISSIPPI
 BOARD OF WATER COMMISSIONERS
 416 North State Street
 Jackson, Mississippi 39201

WATER WELL DRILLERS LOG

Aug 7 1973 McMillan Well Works Harrison
 date well completed firm name county well located

LANDOWNER: Paul Blzhus
4502 Jefferson Ave.
Julport, Miss.
 (mailing address)

Description of formations encountered	from	to
<u>sand</u>	<u>0</u>	<u>18</u>
<u>blue clay</u>	<u>18</u>	<u>46</u>
<u>concrete sand</u>	<u>46</u>	<u>60</u>

WELL LOCATION:

sec. 17 T. 7 N R. 10 E
4 miles N.E. of Julport
 (distance) (direction) (nearest town)

WELL PURPOSE: irrigation
 (home, irrigation, municipal, industrial)

WELL COMPLETION DATA:

- (1) diameter (inches) 2"
- (2) total depth (feet) 60'
- (3) static water level (feet) 3' below/above top of ground
- (4) casing plastic 50'
 (material) (depth)
- (5) screen 10' (length) (depth to top)
2" (size) plastic (material)
- (6) pump 1/2 (HP) 11 (yield gpm)
electric (type power)
- (7) electric log no (yes or no)

CODED

(organization running log)


(8) how well bottom plugged sand
sharp

DRILLERS REMARKS:

RECORDED
 INDEXED
 MAY - 2 1974

If well telescopes please sketch and show depths.

GROUND LEVEL

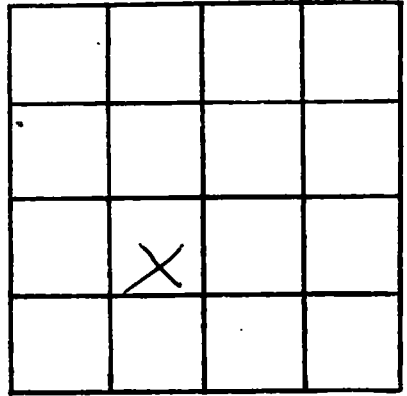

SECTION 17

Please indicate well location X:

ADDITIONAL INFORMATION

If more than one screen,
show locations of each on sketch.