

HARRISON
 S. W.
 M 627
 3-22-73

MISSISSIPPI
 BOARD OF WATER COMMISSIONERS
 416 North State Street
 Jackson, Mississippi 39201

WATER WELL DRILLERS LOG

3-22 1973 McNeil Well Works, Harrison
 date well completed firm name county well located

LANDOWNER: P.O. Box 6632

description of formations encountered from to

Handsboro Presbyterian Church

Sands 0 30

Gulfport Ms.
 (mailing address)

WELL LOCATION:

sec 30 T 7 N R 10 E
5 miles S of Gulfport
 (distance) (direction) (nearest town)

WELL PURPOSE: industrial
 (home, irrigation, municipal, industrial)

WELL COMPLETION DATA:

- (1) diameter (inches) 2"
- (2) total depth (feet) 30'
- (3) static water level (feet) - below top of ground above
- (4) casing plastic 20'
 (material) (depth)
- (size) if telescope see back.
- (5) screen 10'
 (length) (depth to top)
2" plastic
 (size) (material)
- (6) pump 1/2 12
 (HP) (yield gpm)
electric
 (type power)
- (7) electric log No
 (yes or no)

CODED

(organization running log)


(8) how well bottom plugged sand
sharp

DRILLERS REMARKS:

MISSISSIPPI BOARD OF WATER COMMISSIONERS
 MAY - 10 1973

If well telescopes please sketch and show depths.

GROUND LEVEL

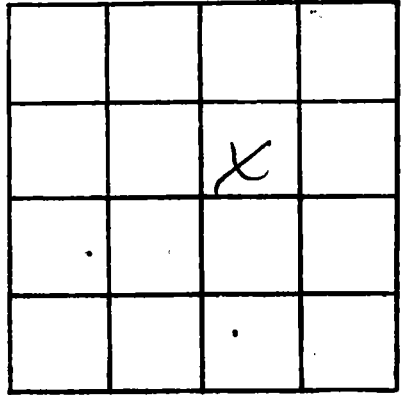

SECTION W

Please indicate well location X.

ADDITIONAL INFORMATION

If more than one screen, show locations of each on sketch.