

S.W.
 HARRISON
 M 629
~~287-73~~

MISSISSIPPI
 BOARD OF WATER COMMISSIONERS
 416 North State Street
 Jackson, Mississippi 39201

WATER WELL DRILLERS LOG

July 1973 M. G. Well Works Harrison
 date well completed firm name county well located

LANDOWNER: C. G. Roberts
Shelport, Mo
 (mailing address)

description of formations encountered	from	to
<u>Sand</u>	<u>0</u>	<u>30</u>

WELL LOCATION:
 sec 29 T 7 N R 10 E
6 miles E of Shelport
 (distance) (direction) (nearest town)

WELL PURPOSE: irrigation
 (home, irrigation, municipal, industrial)


- WELL COMPLETION DATA:
- (1) diameter (inches) 2"
 - (2) total depth (feet) 30'
 - (3) static water level (feet) 41 below above top of ground.
 - (4) casing Asitic 20'
 (material) (depth)
— if telescope see back.
 (size)
 - (5) screen 10' —
 (length) (depth to top)
2" plastic
 (size) (material)
 - (6) pump 1/2 11
 (HP) (yield gpm)
electric
 (type power)
 - (7) electric log no
 (yes or no)
—
 (organization running log)
 - (8) how well bottom plugged Sand
shark

CODED

DRILLERS REMARKS: _____

If well telescopes please sketch and show depths.

GROUND LEVEL

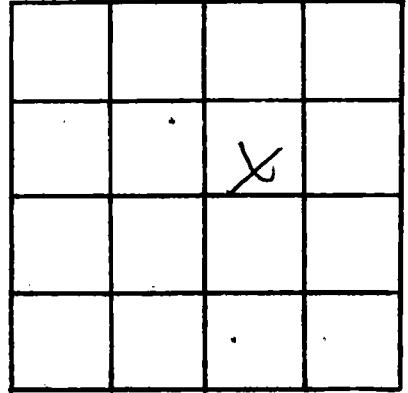

SECTION 29

Please indicate well location X.

ADDITIONAL INFORMATION

If more than one screen, show locations of each on sketch.