

HARRISON  
S.W.  
17630  
3-16-73  
3/16

MISSISSIPPI  
BOARD OF WATER COMMISSIONERS  
416 North State Street  
Jackson, Mississippi 39201

WATER WELL DRILLERS LOG

234 McMill Well Works Harrison  
firm name county well located

date well completed

LANDOWNER: Mrs. Bremer  
107 Edgewater Drive  
Biloxi, Mo.  
(mailing address)

description of formations encountered	from	to
sand	0	30

WELL LOCATION:

sec 34 T 7 N R 10 E  
6 miles W of Biloxi  
(distance) (direction) (nearest town)

WELL PURPOSE: Irrigation  
(home, irrigation, municipal, industrial)

WELL COMPLETION DATA:

- (1) diameter (inches) 2"
- (2) total depth (feet) 30'
- (3) static water level (feet) 4' below above top of ground
- (4) casing plastic 20' (material) (depth)  
if telescope see back.
- (5) screen 10' (length) (depth to top)  
2" plastic (size) (material)
- (6) pump 1/2 (HP) 10 (yield gpm)  
electric (type power)
- (7) electric log no (yes or no)  
(organization running log)
- (8) how well bottom plugged sand shale


CODED

DRILLERS REMARKS:

MAY 2 1973

If well telescopes please sketch and show depths.

GROUND LEVEL

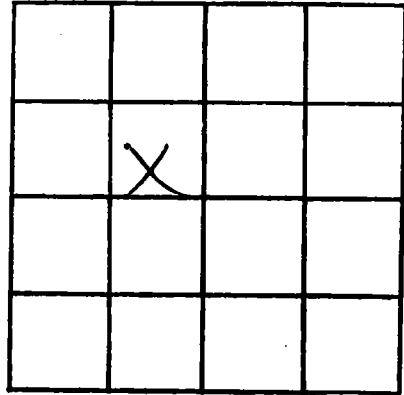

SECTION 34

Please indicate well location X.

ADDITIONAL INFORMATION

If more than one screen, show locations of each on sketch.