

Harrison
S.W.
M 632
3-13-73

MISSISSIPPI
BOARD OF WATER COMMISSIONERS
416 North State Street
Jackson, Mississippi 39201

WATER WELL DRILLERS LOG

March 13, 1973 Mc Gill well works Harrison
date well completed firm name county well located

LANDOWNER: Pro. Simon
114 Dow Circle
Miss City, Mo.
(mailing address)

description of formations encountered	from	to
	<u>sand</u>	<u>0</u>

WELL LOCATION:
sec. 22 T 7 N R 10 E
8 miles West of Bilpie
(distance) (direction) (nearest town)

WELL PURPOSE: Irrigation
(home, irrigation, municipal, industrial)

- WELL COMPLETION DATA:
- (1) diameter (inches) 2"
 - (2) total depth (feet) 30'
 - (3) static water level (feet) 4' below top of ground.
 - (4) casing plastic 30'
(material) (depth)
 - _____ if telescope see back.
(size)
 - (5) screen 10' _____
(length) (depth to top)
 - 2" _____
(size) (material) plastic
 - (6) pump 1/2 10
(HP) (yield gpm)
 - electric
(type power)
 - (7) electric log no
(yes or no)
 - _____ (organization running log)
 - (8) how well bottom plugged sand
mark


CODED

DRILLERS REMARKS:

MISS

If well telescopes please sketch and show depths.

GROUND LEVEL

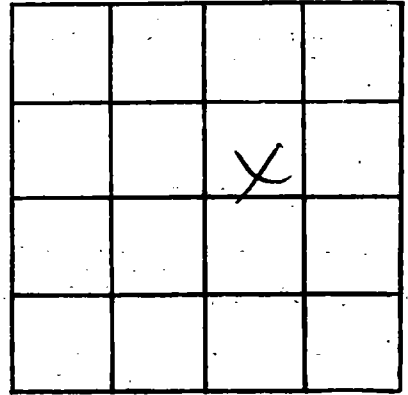

SECTION 32

Please indicate well location X.

ADDITIONAL INFORMATION

If more than one screen, show locations of each on sketch.