

**MISSISSIPPI
BOARD OF WATER COMMISSIONERS**
416 North State Street
Jackson, Mississippi 39201

WATER WELL DRILLERS LOG

S.W.
HARRISON
M 633
8-6-73

Aug. 6 1973 McGil Well Works Harrison
date well completed firm name county well located

LANDOWNER: D.R. Boyd
309 - 45th.
Geet. Mo
(mailing address)

description of formations encountered	from	to
<u>sand</u>	<u>0</u>	<u>30</u>

WELL LOCATION:
sec. 22 T 7 N R 10 E
4 miles E of Bullport
(distance) (direction) (nearest town)

WELL PURPOSE: irrigation
(home, irrigation, municipal, industrial)


- WELL COMPLETION DATA:
- (1) diameter (inches) 2"
 - (2) total depth (feet) 30'
 - (3) static water level (feet) 4' below above top of ground.
 - (4) casing plastic 20'
(material) (depth)
 - if telescope see back.
(size)
 - (5) screen 10' —
(length) (depth to top)
 - 2" plastic
(size) (material)
 - (6) pump 1/2 11
(HP) (yield gpm)
 - electric
(type power)
 - (7) electric log no
(yes or no)
 - (organization running log)
 - (8) how well bottom plugged none
plug

CODED

DRILLERS REMARKS: _____

If well telescopes please sketch and show depths.

GROUND LEVEL

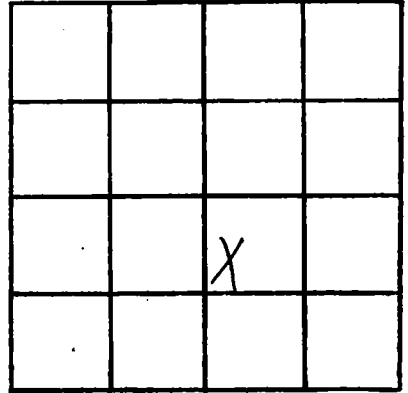

SECTION 32

Please indicate well location X.

ADDITIONAL INFORMATION

If more than one screen,
show locations of each on sketch.