

**HARRISON**  
 S. W  
 7-23-73  
 M 635

MISSISSIPPI  
 BOARD OF WATER COMMISSIONERS  
 416 North State Street  
 Jackson, Mississippi 39201

WATER WELL DRILLERS LOG

July 23 1973 Mc Hill Well Works Harrison  
 date well completed firm name county well located

LANDOWNER: Ben Hoffma  
4206 Pass Road  
Shelfport, Miss  
 (mailing address)

description of formations encountered	from	to
<u>Sand</u>	<u>0</u>	<u>30</u>


WELL LOCATION:  
 sec. 26 7 N R 10 E  
S W  
5 miles East of Biloxi  
 (distance) (direction) (nearest town)

WELL PURPOSE: irrigation  
 (home, irrigation, municipal, industrial)

- WELL COMPLETION DATA:
- (1) diameter (inches) 2"
  - (2) total depth (feet) 30'
  - (3) static water level (feet) 4' below above top of ground.
  - (4) casing plastic 20'  
 (material) (depth)  
 (size) If telescope see back.
  - (5) screen 10' —  
 (length) (depth to top)  
2" plastic  
 (size) (material)
  - (6) pump 1/2 10  
 (HP) (yield gpm)  
electric  
 (type power)
  - (7) electric log NO  
 (yes or no)  
 (organization running log)
  - (8) how well bottom plugged Sand  
shark

**CODED**


DRILLERS REMARKS:

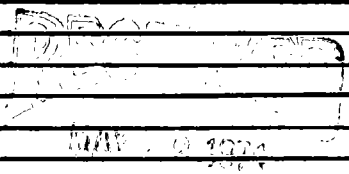

1100  
 1973

If well telescopes please sketch and show depths.

GROUND LEVEL

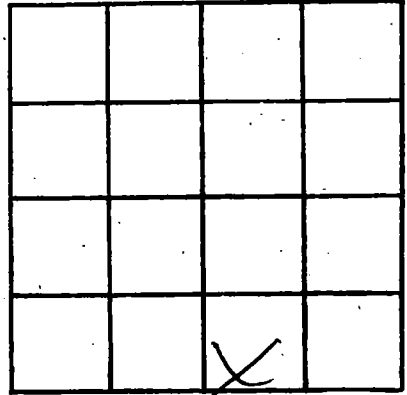

SECTION 26

Please indicate well location X.

ADDITIONAL INFORMATION

If more than one screen, show locations of each on sketch.