

HARRISON

M 636

4-5-74

MISSISSIPPI  
BOARD OF WATER COMMISSIONERS  
416 North State Street  
Jackson, Mississippi 39201

CODED


WATER WELL DRILLERS LOG

5 April 1974 BAYENT WELL CO HARRISON  
date well completed firm name county well located

LANDOWNER: <u>AL BARNES</u>	description of formations encountered	from	to
<u>WETZEL DR.</u>	<u>CLAY</u>	<u>0</u>	<u>17</u>
<u>N. Biloxi, Ms.</u> (mailing address)	<u>SAND</u>	<u>17</u>	<u>24</u>
WELL LOCATION:	<u>CLAY</u>	<u>24</u>	<u>47</u>
sec <u>24</u> T <u>7</u> S R <u>12</u> W	<u>SAND</u>	<u>47</u>	<u>83</u>
<u>1</u> miles <u>N</u> of <u>Biloxi</u>	<u>CLAY</u>	<u>83</u>	<u>89</u>
(distance) (direction) (nearest town)	<u>SAND</u>	<u>89</u>	<u>96</u>
WELL PURPOSE: <u>HOME</u> (home, irrigation, municipal, industrial)	<u>CLAY</u>	<u>96</u>	<u>147</u>
WELL COMPLETION DATA:	<u>SAND</u>	<u>147</u>	<u>151</u>
(1) diameter (inches) <u>2</u>	<u>CLAY</u>	<u>151</u>	<u>199</u>
(2) total depth (feet) <u>400</u>	<u>SAND</u>	<u>199</u>	<u>206</u>
(3) static water level (feet) <u>24'</u> below top of ground.	<u>CLAY</u>	<u>206</u>	<u>226</u>
(4) casing <u>6.25"</u> , <u>390'</u> (material) (depth)	<u>SAND</u>	<u>226</u>	<u>239</u>
<u>      </u> If telescope see back. (size)	<u>CLAY</u>	<u>239</u>	<u>281</u>
(5) screen <u>10"</u> , <u>390'</u> (length) (depth to top)	<u>SAND</u>	<u>281</u>	<u>299</u>
<u>2"</u> , <u>3/5"</u> (size) (material)	<u>CLAY</u>	<u>299</u>	<u>344</u>
(6) pump <u>1</u> HP, <u>10</u> yield gpm	<u>SAND</u>	<u>344</u>	<u>400</u>
<u>ELECT</u> (type power)			
(7) electric log <u>NO</u> (yes or no)			
<u>      </u> (organization running log)			
(8) how well bottom plugged <u>METAL</u> <u>SAND</u> <u>SAND</u>			
DRILLERS REMARKS:			

If well telescopes please  
sketch and show depths.

GROUND LEVEL

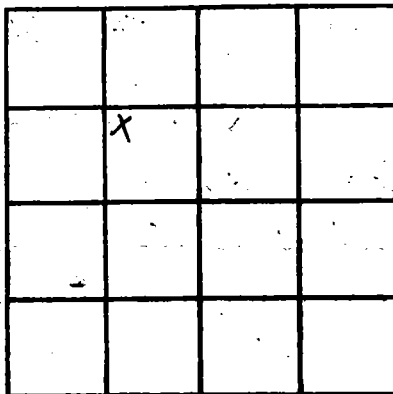

SECTION 24

Please indicate well location X.

ADDITIONAL INFORMATION

If more than one screen,  
show locations of each on sketch.