

HARRISON
M637
2-17-74

MISSISSIPPI
BOARD OF WATER COMMISSIONERS
416 North State Street
Jackson, Mississippi 39201

WATER WELL DRILLERS LOG
COASTAL DRILLING & SERVICE CO.

CODED

2/17 1974 date well completed
ROUTE 1 BOX 618 address
Harrison county well located

LANDOWNER: Herman C. Harrison
125 E Jackson
Biloxi, Miss
(mailing address)

description of formations encountered	from	to
top soil	1	3
white sand	3	120
Soft Blue Clay	120	290
fine water sand	290	315
hard blue clay	315	420
Rock	420	422
fine water sand	422	470
Coarse water sand	470	525

WELL LOCATION: Sec. 75 9W
City of Biloxi
N E W
S R E W
(distance) (direction) (nearest town)

WELL PURPOSE: home
(home, irrigation, municipal, industrial)

- WELL COMPLETION DATA:
- (1) diameter (inches) 2"
 - (2) total depth (feet) 525'
 - (3) static water level (feet) 20 below above top of ground
 - (4) casing PVC 515' (material) (depth)
 - (size) If telescope see back.
 - (5) screen 10' 515 (length) (depth to top)
2" PVC (size) (material)
 - (6) pump 70 pump (HP) (yield gpm)
(type power)
 - (7) electric log no (yes or no)

CODED

(organization running log)
(8) flow well bottom plugged no
check well valve


DRILLERS REMARKS:

RECEIVED

AUG 15 1974

If well telescopes please sketch and show depths.

GROUND LEVEL

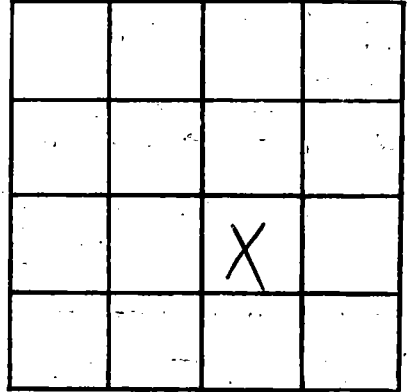

SECTION _____

Please indicate well location X.

ADDITIONAL INFORMATION

If more than one screen, show locations of each on sketch.