

Harrison
 M 645
 1-28-75

MISSISSIPPI
 BOARD OF WATER COMMISSIONERS
 416 North State Street
 Jackson, Mississippi 39201
 WATER WELL DRILLERS LOG

CODED

1/28 1975 M.B. Drilling Co. Harrison
 date well completed firm name county well located
 Charles Kousch

LANDOWNER: Mrs. Oletto
 P.O. Box 90
 B. Loxi, Miss. 39532
 (mailing address)

description of formations encountered	from	to
Sand	0	20
ght clay	20	25
Sand	25	110
Blue Clay	110	330
Sand	330	355
Blue clay	355	450
Sand	450	570
Bottom	570	+


WELL LOCATION:
 sec. 11 T. 7 R. 10 S. 135
 2 miles SW of Columbus
 (distance) (direction) (nearest town)

WELL PURPOSE: Home & Trailer
 (home, irrigation, municipal, industrial)

WELL COMPLETION DATA:
 (1) diameter (inches) 4x2
 (2) total depth (feet) 570
 (3) static water level (feet) 25 below top of ground
 (4) casing PVC Total
 (material) (depth)
 4x2 (size) if telescope see back.
 (5) screen 10ft 560
 (length) (depth to top)
 2" PVC
 (size) (material)
 (6) pump 1/2 sub 25 gpm
 (HP) (yield gpm)
 220 v 10
 (type power)
 (7) electric log No
 (yes or no)
 (organization running log)

(8) how well bottom plugged?
 Back Wash Valve

DRILLERS REMARKS:

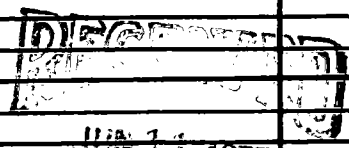


JUN 21 1975

MISS. BD. OF WATER COMM

If well telescopes please sketch and show depths.

GROUND LEVEL

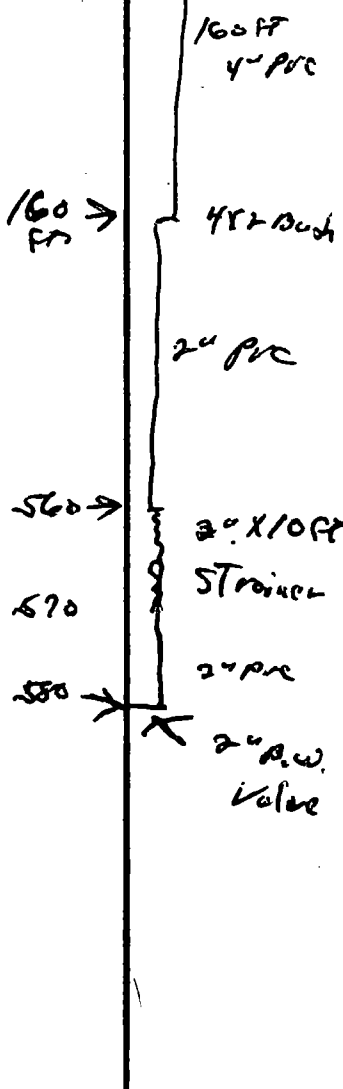

		X	

SECTION 11

Please indicate well location X.

ADDITIONAL INFORMATION

If more than one screen, show locations of each on sketch.