

Harrison
 M 646
 1-30-75

MISSISSIPPI
 BOARD OF WATER COMMISSIONERS
 416 North State Street
 Jackson, Mississippi 39201

WATER WELL DRILLERS LOG

CODED

8/30 - 1975 date well completed
 75 Mt B Drilling Co. Harrison firm name
 county well located

LANDOWNER: ~~T. Byrd~~
 Jerry Byrd - Highway 67
 Bi.oxi, Miss.
 (mailing address)

description of formations encountered	from	to
white clay	0	25
white sand	25	55
blue clay	55	270
sand	270	275
blue clay	275	280
sand	280	315
	315	F

WELL LOCATION:
 sec. 6 T. 7 S. R. 9 E 13S
 1/2 miles E of Charlotte
 (distance) (direction) (nearest town)

WELL PURPOSE: Home
 (home, irrigation, municipal, industrial)

WELL COMPLETION DATA:

(1) diameter (inches) 2"

(2) total depth (feet) 315

(3) static water level (feet) 20 below above top of ground.

(4) casing PVC 315
 (material) (depth)
2"
 (size) If telescope see back.


(5) screen 10 305
 (length) (depth to top)
2" PVC
 (size) (material)

(6) pump 1/2 10
 (HP) (yield gpm)
115V 1P
 (type power)

(7) electric log No
 (yes or no)

(organization running log)

(8) how well bottom plugged B. Wash
Kalua

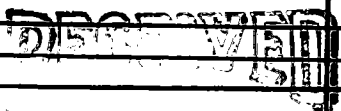

DRILLERS REMARKS:

JUN 11 1975

If well telescopes please sketch and show depths.

GROUND LEVEL

X			

SECTION 6

Please indicate well location X.

ADDITIONAL INFORMATION

If more than one screen,
show locations of each on sketch.