

HARRISON
M 651
6/22/78

MISSISSIPPI
BOARD OF WATER COMMISSIONERS
416 North State Street
Jackson, Mississippi 39201

CODED

WATER WELL DRILLERS LOG

6/22/78 19 *Coastal Drilling* *Harrison*
date well completed firm name county well located
Bilal *Miss*

LANDOWNER *Ray Ormet*
St 5
North Bilal, Miss
(mailing address)

description of formations encountered	from	to
<i>Top Soil</i>	<i>1</i>	<i>3</i>
<i>Red Clay</i>	<i>3</i>	<i>15</i>
<i>hard pink clay</i>	<i>15</i>	<i>40</i>
<i>Coarse white sand</i>	<i>40</i>	<i>90</i>
<i>fine sand</i>	<i>90</i>	<i>140</i>
<i>Soft Blue Clay</i>	<i>150</i>	<i>230</i>
<i>fine water sand</i>	<i>230</i>	<i>270</i>
<i>Soft blue clay</i>	<i>270</i>	<i>360</i>
<i>hard blue clay</i>	<i>360</i>	<i>570</i>
<i>fine water sand</i>	<i>570</i>	<i>580</i>
<i>hard blue clay</i>	<i>580</i>	<i>690</i>
<i>fine water sand</i>	<i>690</i>	<i>700</i>
<i>Coarse white sand</i>	<i>700</i>	<i>745</i>

WELL LOCATION:
sec. *7* T. *7* N. R. *9* E
2 1/2 miles *North Bilal*
(distance) (direction) (nearest town)

WELL PURPOSE: *home*
(home, irrigation, municipal, industrial)

WELL COMPLETION DATA:
(1) diameter (inches) *4 1/2"*
(2) total depth (feet) *745'*
(3) static water level (feet) *40* below above top of ground.
(4) casing *PVC* *730'*
(material) (depth)
(size) if telescope see back.
(5) screen *15'* *730'*
(length) (depth to top)
2" *PVC*
(size) (material)
(6) pump *2 1/2* *35*
(HP) (yield gpm)
Ele
(type power)
(7) electric log *no*
(yes or no)
(organization running log)

(8) how well bottom plugged
2 1/2" sand washed

DRILLERS REMARKS:

Miss. Board of Water Comm.

FEB 8 1979

If well telescopes please sketch and show depths.


GROUND LEVEL

200ft 4" PVC
Casing

530' 3" PVC
Casing

15ft 2" PVC
Screen

2" check water valve

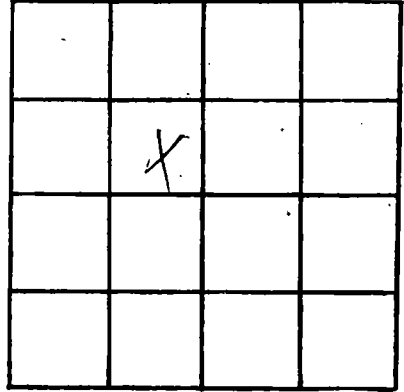

SECTION _____

Please indicate well location X.

ADDITIONAL INFORMATION

If more than one screen,
show locations of each on sketch.