

Harrison  
 M 653  
 5-18-75  
 5/18/75  
 date well completed

MISSISSIPPI  
 BOARD OF WATER COMMISSIONERS  
 416 North State Street  
 Jackson, Mississippi 39201

WATER WELL DRILLERS LOG

COASTAL DRILLING & SERVICE CO. *Harrison*  
 ROUTE # *1* BOX 618 county well located

CODED

LANDOWNER: *C. Pope*  
*Rt 2 Box 538*  
*Biloxi, Miss*  
 (mailing address)

WELL LOCATION: *135*  
 sec. *L 7 N R 10 E*  
*Cedar Lake*  
 (distance) miles (direction) of (nearest town)

WELL PURPOSE: *Home*  
 (home, irrigation, municipal, industrial)

- WELL COMPLETION DATA:
- (1) diameter (inches) *2"*
  - (2) total depth (feet) *320'*
  - (3) static water level (feet) *25* below above top of ground.
  - (4) casing *PVC* *310'*  
 (material) (depth)  
 (size) if telescope see back.
  - (5) screen *10'* *310'*  
 (length) (depth to top)  
*2"* *PVC*  
 (size) (material)
  - (6) pump *One* *12*  
 (HP) (yield gpm)  
*Ele*  
 (type power)
  - (7) electric log *No*  
 (yes or no)
- (organization running log)

Description of Formations encountered	from	to
<i>Top Soil</i>	<i>1</i>	<i>3</i>
<i>Red sandy clay</i>	<i>3</i>	<i>26</i>
<i>White sand</i>	<i>26</i>	<i>75</i>
<i>Soft sand</i>	<i>75</i>	<i>220</i>
<i>Shell</i>	<i>220</i>	<i>222</i>
<i>fine water sand</i>	<i>222</i>	<i>240</i>
<i>hard blue clay</i>	<i>240</i>	<i>290</i>
<i>fine water sand</i>	<i>290</i>	<i>300</i>
<i>Coarse water sand</i>	<i>300</i>	<i>325</i>

(8) how well bottom plugged  
*2' back with rubble*


DRILLERS REMARKS:

RECEIVED  
 JUL 17 1975

MISS. BD. OF WATER COMM

If well telescopes please sketch and show depths.

GROUND LEVEL

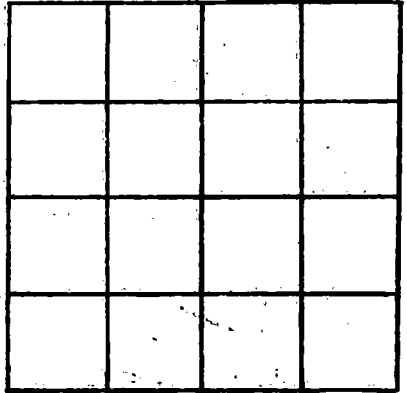

SECTION \_\_\_\_\_

Please indicate well location X.

ADDITIONAL INFORMATION

If more than one screen, show locations of each on sketch.