

HARRISON  
M 656  
3-19-76

MISSISSIPPI  
BOARD OF WATER COMMISSIONERS  
416 North State Street  
Jackson, Mississippi 39201

CODED

WATER WELL DRILLERS LOG

3/19/76 19 Menge Well & Pump Co. Harrison  
date well completed firm name county well located

LANDOWNER: Broadwater  
Beach, Hotel - P.O. Box 127  
Biloxi, Miss. 39533  
(mailing address)

WELL LOCATION:  
Sun Golf Course  
sec. 35 T 170 N R 100 E  
miles In Biloxi  
(distance) (direction) (nearest town)

WELL PURPOSE: Irrigation  
(home, irrigation, municipal, industrial)

description of formations encountered

from to

Sand	0	42
Sticky clay	42	83
Hard brittle shale	83	180
Fine sand	180	250
Hard brittle shale	250	330
Hard shale	330	416
Gray sand	416	469
Soft shale	469	560
Sandy shale	560	585
Fine sand	585	635
Me. to course sand	635	677

WELL COMPLETION DATA:

- diameter (inches) 8x4
- total depth (feet) 676.9'
- static water level (feet) 50 below above top of ground.
- casing 8" steel, 637.3 (material) (depth)  
4" (size) if telescope see back.
- screen 25' 650.4' (length) (depth to top)  
4" S.S. wire wrap (size) (material)
- pump 5 300 (MAX) (HP) (yield gpm)  
Electric (type power)
- electric log No (yes or no)

(organization running log)

- how well bottom plugged Cost iron back pressure valve

DRILLERS REMARKS:


Did not go through sand strata.

CODED

RECORDED  
APR 16 1976

MISS. BD. OF WATER COMM

If well telescopes please sketch and show depths.

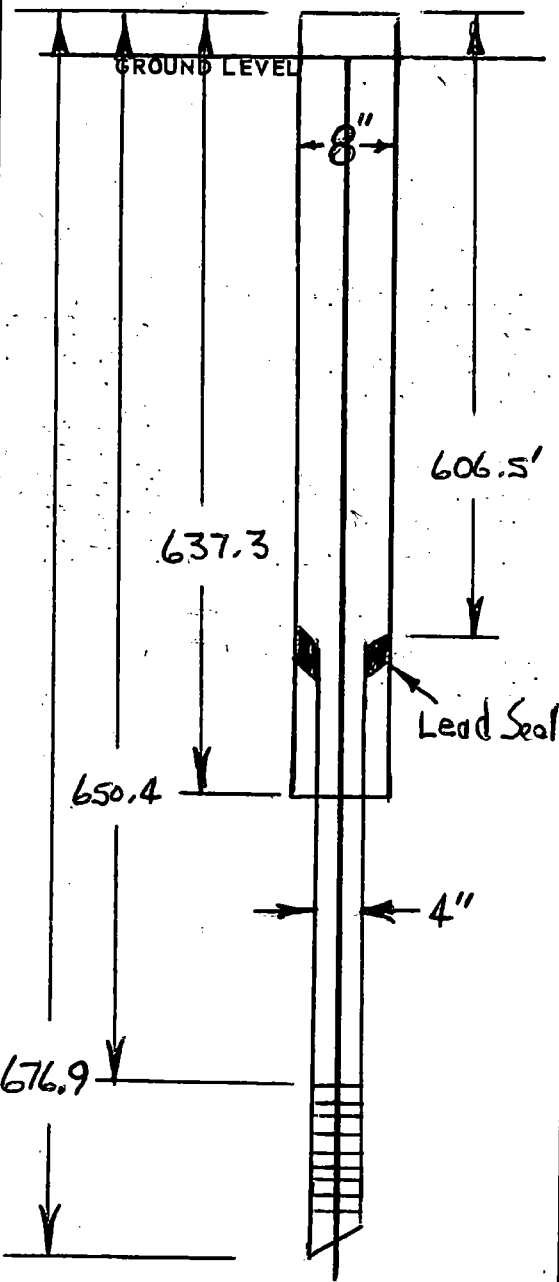


SECTION \_\_\_\_\_

Please indicate well location X.

ADDITIONAL INFORMATION

Lower 200' casing  
Cemented

If more than one screen,  
show locations of each on sketch.