

M 660
 Harrison
 5/7/75

MISSISSIPPI
 BOARD OF WATER COMMISSIONERS
 416 North State Street
 Jackson, Mississippi 39201

CODED


WATER WELL DRILLERS LOG

7 MAY 1975 BAYBENT WELL CO HARRISON
 date well completed firm name county well located

LANDOWNER: P. B. MCCEIN	description of formations encountered	from	to
612 ROSEMARY ST	Top soil	0	2
Gulfport, Ms. (mailing address)	COARSE SAND	2	30
WELL LOCATION:			
sec. 31 T 7 S R 10 W			
1 N miles City of Gulfport (distance) (direction) (nearest town)			
WELL PURPOSE: Irrigation (home, irrigation, municipal, industrial)			
WELL COMPLETION DATA:			
(1) diameter (inches) 4"			
(2) total depth (feet) 30'			
(3) static water level (feet) 3 below top of ground.			
(4) casing PVC, 2.5 (material) (depth)			
_____ If telescope see back. (size)			
(5) screen 5, 2.5 (length) (depth to top)			
Ø 10, PVC (size) (material)			
(6) pump 1/2, 2.5 (HP) (yield gpm)			
ELECT (type power)			
(7) electric log _____ (yes or no)			
_____ (organization running log)			
(8) how well bottom plugged PVC G&P			
DRILLERS REMARKS:			
JUN 3 1975 MISS. BD. OF WATER COMMISSIONERS			

If well telescopes please sketch and show depths.

GROUND LEVEL

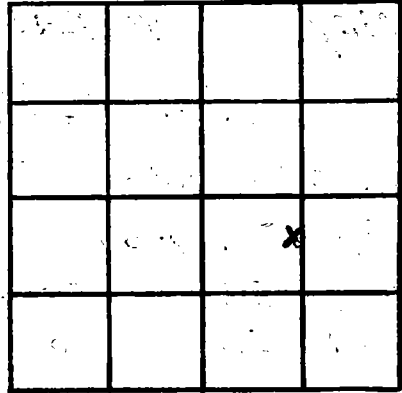

SECTION 31

Please indicate well location X.

ADDITIONAL INFORMATION

If more than one screen, show locations of each on sketch.