

HARRISON
M 661
6-30-80

MISSISSIPPI
BOARD OF WATER COMMISSIONERS
416 North State Street
Jackson, Mississippi 39201
WATER WELL DRILLERS LOG

CGED

6-30 date well completed
1980 Braten Pump and Well Serv. Inc firm name
HARRISON county well located

LANDOWNER:
Liles Construction Co.
P.O. Box 2061
Montgomery, Alabama
(mailing address)

description of formations encountered	from	to
CLAY	0	100
SAND	100	135
CLAY	135	200
SAND	200	250
CLAY	250	300
SAND	300	315
CLAY	315	480
SAND	480	550

WELL LOCATION:
sec. 18 T. 7 S. R. 9 W.
7 miles IN of Biloxi
(distance) (direction) (nearest town)

WELL PURPOSE: shopping center
(home, irrigation, municipal, industrial)

- WELL COMPLETION DATA:
- (1) diameter (inches) 8" x 6"
 - (2) total depth (feet) 550'
 - (3) static water level (feet) 75' below top of ground
 - (4) casing steel (material), total (depth)
8" x 6" (size) If telescope see back.
 - (5) screen 50 (length), 500 (depth to top)
6" (size), stainless steel (material)
 - (6) pump 30 (HP), 380 (yield gpm)
230 (type power)
 - (7) electric log no (yes or no)
 - (organization running log)
 - (8) how well bottom plugged
6" back wash

DEPT. OF NATURAL RESOURCES
BUREAU OF LAND & WATER RESOURCES

OCT - 6 1980

RECEIVED

DRILLERS REMARKS:
no tail pipe

If well telescopes please sketch and show depths.

DEPT. OF NATURAL RESOURCES
 BUREAU OF LAND & WATER RESOURCES

OCT - 6 1980


RECEIVED

X			

SECTION 18

Please indicate well location X.

ADDITIONAL INFORMATION

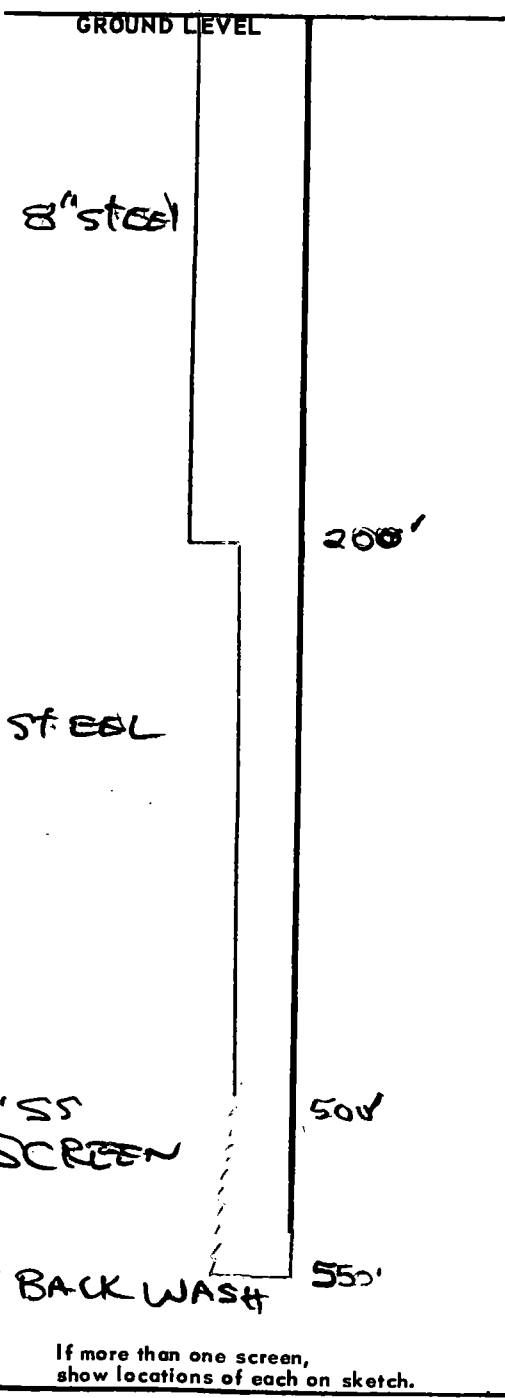

If more than one screen,
 show locations of each on sketch.