

MISSISSIPPI DEPARTMENT OF NATURAL RESOURCES

Bureau of Land and Water Resources

Southport Mall

P.O. Box 10631

CODED

Jackson, Mississippi 39209

WATER WELL DRILLERS LOG

COASTAL DRILLING & SERVICE CO. *Harrison*

ROUTE 1 BOX 618

county well located

Harrison
M 663
11/6/79

date well completed

LANDOWNER:

CM - plumer

BILOXI, MISS. 39532
description of formations encountered

from to

Rt 1 Woodaket

Biloxi Min
(mailing address)

<i>top soil</i>	1	3
<i>red clay</i>	3	18
<i>Coarse white sand</i>	18	40
<i>Soft Blue Clay</i>	40	210
<i>hard Blue Clay</i>	210	360
<i>fine white sand</i>	360	360
<i>Coar. with sand</i>	360	385

WELL LOCATION:

sec. *4* T. *2* N. R. *10* E. W.

Coalville
(distance) (direction) of (nearest town)

WELL PURPOSE: *plumer well*
(home, irrigation, municipal, industrial)

WELL COMPLETION DATA:

- (1) diameter (inches) *4"*
- (2) total depth (feet) *385'*
- (3) static water level (feet) *60'* below above top of ground
- (4) casing *PDC* *370'*
(material) (depth)
- (5) screen *15'* *370'*
(length) (depth to top)
- 4"*
(size) *PDC*
(material)
- (6) pump *3HP* *45*
(HP) (yield gpm)
- Elc*
(type power)
- (7) electric log *no*
(yes or no)

CODED

DEPT. OF NATURAL RESOURCES
BUREAU OF LAND & WATER RESOURCES

NOV - 5 1980

RECEIVED


(8) how well bottom plugged
2" backwash valve

DRILLERS REMARKS: *2-B*

(organization running log)

If well telescopes please sketch and show depths.

GROUND LEVEL

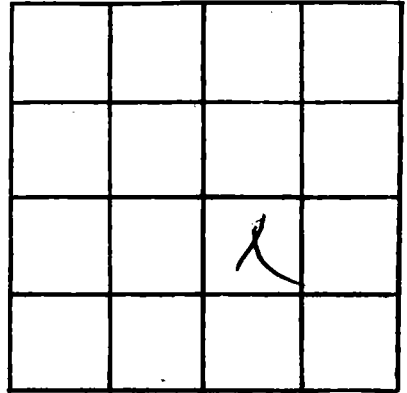

SECTION _____

Please indicate well location X.

ADDITIONAL INFORMATION

If more than one screen,
show locations of each on sketch.