

Harrison
M 666
4-16-75

MISSISSIPPI
BOARD OF WATER COMMISSIONERS
416 North State Street
Jackson, Mississippi 39201

CODED

WATER WELL DRILLERS LOG
COASTAL DRILLING & SERVICE CO.

ROUTE 1 BOX 618
Farm Name

Harrison
county well located

BILOXI MISS. 39532

4/16/75
date well completed

LANDOWNER: T.T. Pusley

description of formations encountered

from

to

Rt. 1 Box 588
Biloxi, Miss
(mailing address)

top soil		3
white sand	3	40
soft suds	40	500
fine white sand	200	215
soft suds	215	250
hard white clay	250	470
coarse white sand	470	520

WELL LOCATION: 135

sec. 2 T 7 N R 10 E
1/2 W
1/2 W
(distance) (direction) (nearest town)

WELL PURPOSE: Domestic
(home, irrigation, municipal, industrial)

WELL COMPLETION DATA:

- (1) diameter (inches) 2"
- (2) total depth (feet) 520'
- (3) static water level (feet) 45 below above top of ground.
- (4) casing PVC, 505'
(material) (depth)
(size) If telescope see back.
- (5) screen 15', 505'
(length) (depth to top)
2" PVC
(size) (material)
- (6) pump 1 1/2 15
(HP) (yield gpm)
elec
(type power)
- (7) electric log no
(yes or no)

(organization running log)

(8) how well bottom plugged

5" back with valve


DRILLERS REMARKS:

RECEIVED
JUL 17 1975

MISS. BD. OF WATER COMMISSIONERS

If well telescopes please sketch and show depths.

GROUND LEVEL

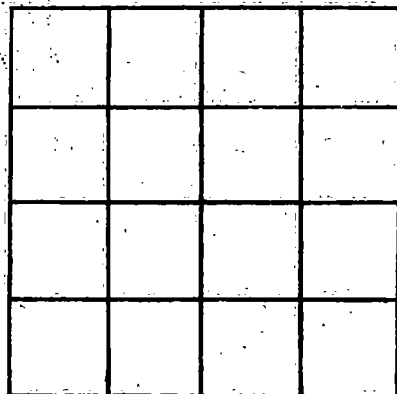

SECTION _____

Please indicate well location X.

ADDITIONAL INFORMATION

If more than one screen, show locations of each on sketch.