

Harrison  
 M 667  
 6-7-75  
 6/7/75  
 date well completed

MISSISSIPPI  
 BOARD OF WATER COMMISSIONERS  
 416 North State Street  
 Jackson, Mississippi 39201

CODED

WATER WELL DRILLERS LOG  
 COASTAL DRILLING & SERVICE CO. Harrison

ROUTE # BOX # 618

county well located

LANDOWNER: Peter Bonney

description of formations encountered

from to

Rt 1  
 Biloxi, Miss  
 (mailing address)

Top Soil	1	3
Red Sand	3	15
White Sand	15	60
Soft Clay	60	125
Silt	105	315
fine water sand	315	325
hard blue clay	325	405
fine water sand	405	420
Coarse water sand	420	465

WELL LOCATION:  
 sec. 2 T 7 N R 10 E  
 S W  
 1 1/2 mile W Cedarsburg  
 (distance) (direction) (nearest town)

WELL PURPOSE: Home  
 (home, irrigation, municipal, industrial)

WELL COMPLETION DATA:

- (1) diameter (inches) 2"
- (2) total depth (feet) 465'
- (3) static water level (feet) 31 below top of ground.
- (4) casing PIC 455' (material) (depth)
- (5) screen 10' 455' (length) (depth to top)
- (6) pump One 12 (HP) (yield gpm)
- Ele (type power)
- (7) electric log Yes (yes or no)
- (organization running log)


(8) how well bottom plugged  
 2" back wash blue

DRILLERS REMARKS:

REGISTERED  
 1975  
 JUL 17 1975

If well telescopes please sketch and show depths.

GROUND LEVEL

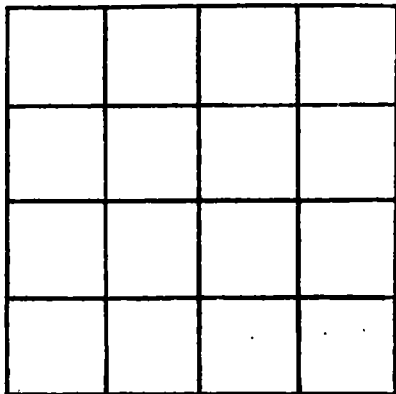

SECTION \_\_\_\_\_

Please indicate well location X.

ADDITIONAL INFORMATION

If more than one screen, show locations of each on sketch.