


HARRISON
M670
12-22-80

MISSISSIPPI
BOARD OF WATER COMMISSIONERS
416 North State Street
Jackson, Mississippi 39201

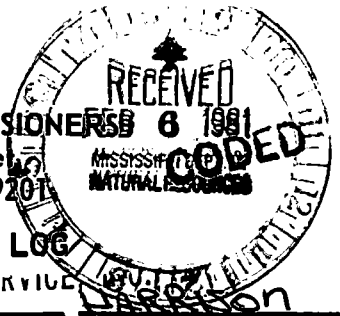

WATER WELL DRILLERS LOG

12-22-80¹⁹ BRADEN PUMP AND WELL SERVICE Jackson
date well completed firm name county well located

LANDOWNER:
Myrtle Yvonne Daugherty
11640 W. Beach

description of formations encountered	from	to
	Sand	0
Clay	70	105
Sand	105	155
Clay	155	160

Biloxi, MS 39530
(mailing address)

WELL LOCATION:

sec 36 7 N 10 E
5 5
10 miles of Biloxi
(distance) (direction) (nearest town)

WELL PURPOSE: home-lawn
(home, irrigation, municipal, industrial)

WELL COMPLETION DATA:

- (1) diameter (inches) 4"
 - (2) total depth (feet) 200'
 - (3) static water level (feet) 10' below top of ground
 - (4) casing PVC, total (material), (depth)
4" (size) If telescope see back.
 - (5) screen 10' (length), 190' (depth to top)
2" (size), 008 PVC underlain (material)
 - (6) pump 1 1/2 (HP), 25 (yield gpm)
230 (type power)
 - (7) electric log NO (yes or no)
- (organization running log)

(8) how well bottom plugged
2" sand shark

DRILLERS REMARKS:

no tail pipe

If well telescopes please sketch and show depths.

GROUND LEVEL

		X	

SECTION 36

Please indicate well location X.

ADDITIONAL INFORMATION

If more than one screen, show locations of each on sketch.