

HARRISON
M 672
8-1-81

MISSISSIPPI
BOARD OF WATER COMMISSIONERS
416 North State Street
Jackson, Mississippi 39201

CODED

WATER WELL DRILLERS LOG

BRADEN PUMP AND WELL SERVICE, INC.

HARRISON

8-1-81
date well completed

19 ROUTE 1, BOX 489

SAUCIER, MS 39574

county well located

LANDOWNER:
LEON BURGESS
Rt 9, Box 20
Gulfport, MS 39503
(mailing address)

description of formations encountered	from	to
SAND	0	15
CLAY	15	30
SAND	30	135
CLAY	135	160
SAND	160	170
CLAY	170	270
SAND	270	285
CLAY	285	290
SAND	290	305
CLAY	305	470
SAND + CLAY	470	480
SAND	480	490
CLAY	490	575
SAND	575	585
CLAY	585	700
SAND	700	740

CODED


WELL LOCATION:
sec. 18 T 7 N R 10 E
1 miles N of Gulfport
(distance) (direction) (nearest town)

WELL PURPOSE: TRAILER PARK
(home, irrigation, municipal, industrial)

WELL COMPLETION DATA:
(1) diameter (inches) 4 X 2
(2) total depth (feet) 740
(3) static water level (feet) 40 below above top of ground.
(4) casing PVC total (material) (depth)
4 X 2 If telescope see back. (size)
(5) screen 10 725 (length) (depth to top)
2" PVC underbar (size) (material)
(6) pump 1 1/2 30 (HP) (yield gpm)
220 (type power)
(7) electric log NO (yes or no)
(organization running log)

(8) how well bottom plugged
2" SAND SHANK


DRILLERS REMARKS:
5' tail pipe

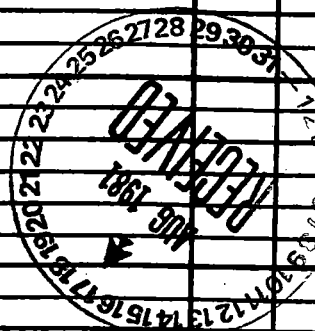

If well telescopes please sketch and show depths.

GROUND LEVEL

4" sch 40
PVC

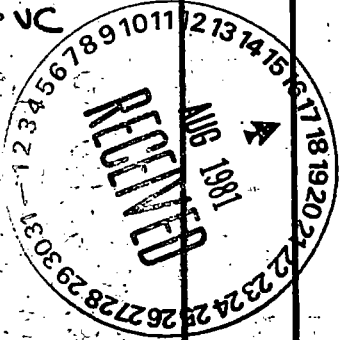

4 x 2 PVC
Bushing

230'

2" sch 40
PVC

PVC underbar
screen

725

735

740

2" sand shark

			X

SECTION 18

Please indicate well location X.

ADDITIONAL INFORMATION

If more than one screen, show locations of each on sketch.