

MISSISSIPPI DEPARTMENT OF NATURAL RESOURCES
Bureau of Land and Water Resources
 Southport Mall
 P.O. Box 10631
 Jackson, Mississippi 39209
WATER WELL DRILLERS LOG

HARRISON
M 676
5-22-82

May 22 1982 Pr Braden Pump & Well Dr. Harrison
 date well completed firm name county well located

LANDOWNER: Kurtis Seaford
East Beach
B. Logi, Miss.
 (mailing address)

WELL LOCATION:
 sec. 39 T 17 S R 9 E W
1/4 miles B. Logi
 (distance) (direction) (nearest town)

WELL PURPOSE: Sealed Well
 (home, irrigation, municipal, industrial)

- WELL COMPLETION DATA:**
- diameter (inches) 8" x 6"
 - total depth (feet) 950
 - static water level (feet) 10 below top of ground
 - casing Steel 890
 (material) (depth)
8" x 6" If telescope see back.
 (size)
 - screen 60 890
 (length) (depth to top)
6" S.S. Underbar
 (size) (material)
 - pump 30 700
 (HP) (yield gpm)
220V 3Ø
 (type power)
 - electric log No
 (yes or no)
- (organization running log)
- (8) how well bottom plugged 6" Back Wash Valve

description of formations encountered	from	to
Surface Fill	0	6
B1 Clay	6	60
Fine Sand	60	150
Blue Clay	150	160
Sand + Clay Breaks	160	300
S Clay	300	320
Fine Sand	320	420
Blue Clay	420	580
Sand	580	595
Clay	595	700
Sand - Fine	700	790
Blue Clay	790	794
Rock	794	794 1/2
Clay	794 1/2	795 1/2
Rock	795 1/2	796
Blue Clay	796	850
Coarse Sand	850	960

DEPT. OF NATURAL RESOURCES
 BUREAU OF LAND & WATER RESOURCES

JUL 20 1982

RECEIVED

DRILLERS REMARKS:

If well telescopes please sketch and show depths.

GROUND LEVEL

8"
Steel

Cemented
to
320 FT

300

8" x 6"
Sewage Nipple


6"
Steel

890

60 FT
S.S. Underdrain
Screen

950

6" Back
Work Check

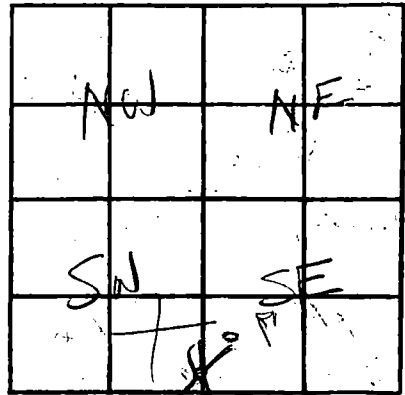

SECTION 34

Please indicate well location X.

ADDITIONAL INFORMATION

If more than one screen,
show locations of each on sketch.