

MISSISSIPPI DEPARTMENT OF NATURAL RESOURCES
Bureau of Land and Water Resources
 Southport Mall
 P.O. Box 10631
 Jackson, Mississippi 39209
WATER WELL DRILLERS LOG

HARRISON
M 679
2/17/82

(FW)
 01769

3-17 1982 Broaden Pumpwell Dr. Harrison
 date well completed firm name county well located

LANDOWNER: West Leatord Co.
East Beach Blvd P.O. Box 273
Biloxi, Miss. 39533
 (mailing address)

description of formations encountered	from	to
Surface Clay	0	4
Black Clay	4	65
Fine Sand	65	85
Blue Clay	85	260
Sand	260	310
Blue Clay	310	570
Sand	570	600
Blue Clay	600	850
Coarse Sand	850	830
		+

WELL LOCATION:
 sec. 34 T. 7 S. R. 9 W.
In miles Biloxi of (distance) (direction) of (nearest town)

WELL PURPOSE: Industrial
 (home, irrigation, municipal, industrial)
Seafood

WELL COMPLETION DATA:
 (1) diameter (inches) 6" x 4"
 (2) total depth (feet) 930 ft
 (3) static water level (feet) 10 below top of ground.
 (4) casing Steel 890 ft
 (material) (depth)
6" x 4" if telescope see back.
 (size)
 (5) screen 40 890
 (length) (depth to top)
4" S.S. Underbar
 (size) (material)
 (6) pump 20 300
 (HP) (yield gpm)
220V 3Ø
 (type power)
 (7) electric log No
 (yes or no)
 (organization running log)

CODED



DEPT. OF NATURAL RESOURCES
 BUREAU OF LAND & WATER RESOURCES

JAN 24 1983

RECEIVED

(8) how well bottom plugged
4" Beach Wash Check
 DRILLERS REMARKS:

If well telescopes please sketch and show depths.

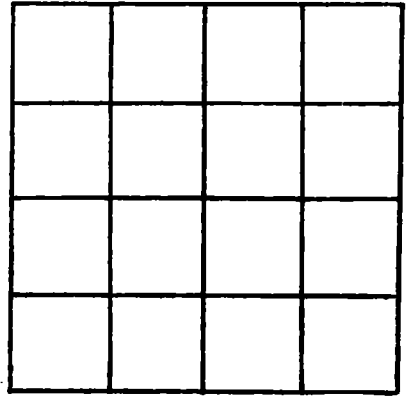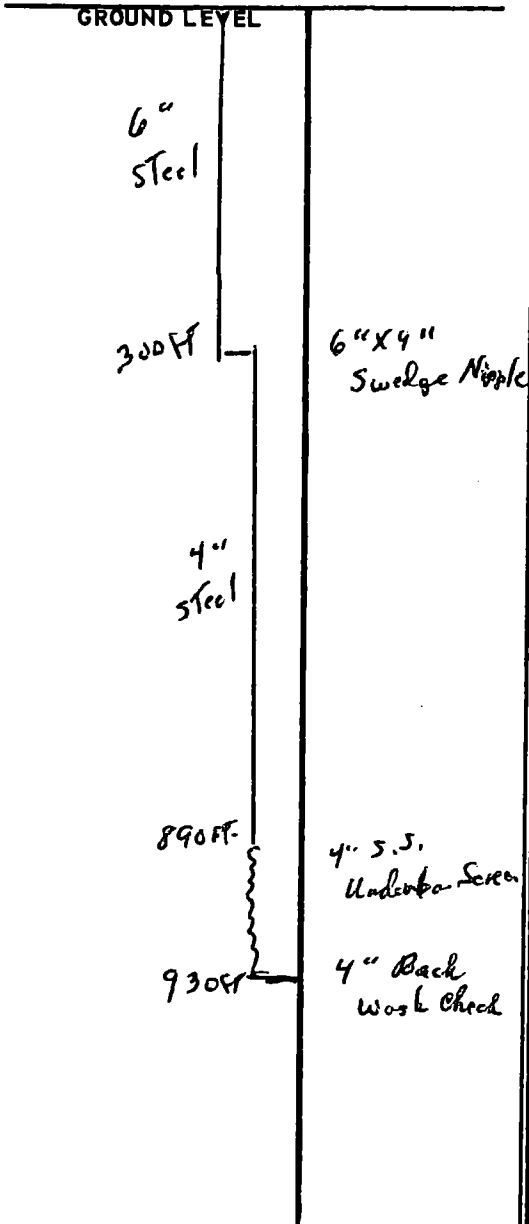

SECTION 34

Please indicate well location X.

ADDITIONAL INFORMATION

A series of horizontal lines for providing additional information.

If more than one screen, show locations of each on sketch.